


Section 15 Township 18 Range 1-W

Well No. #7, SChulz

Company Anderson and Prichard

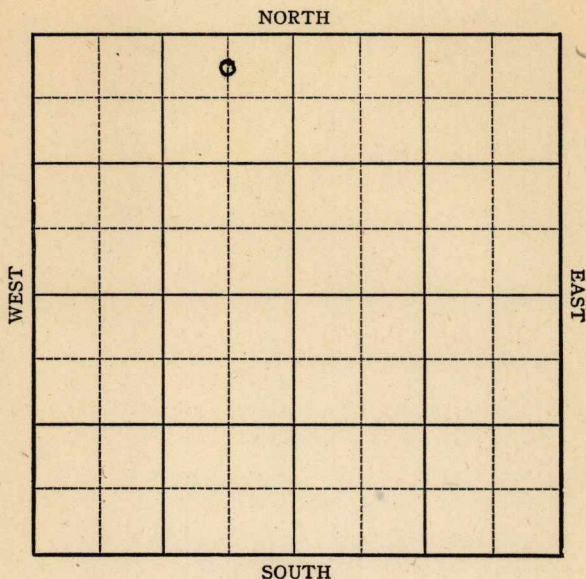

KANSAS

McPherson County ✓

Sec. 15 Twp. 18 R. 1W

Well No. # 7 Schultz Farm

Anderson & Prichard Company


Battle Hill

330 Ft. from N. Line

 Ft. from S. Line

660 Ft. from E. Line

 Ft. from W. Line

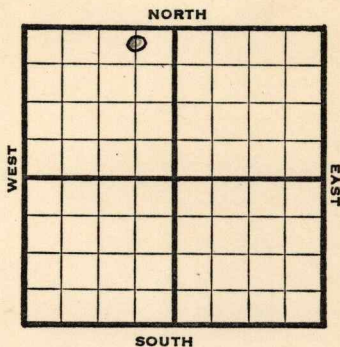

C N L NE NW

1946

1399

REPORT

8/28	Location	
9/5	Drlg 2330'	
9/10	8" @ 188'	
	Miss 2686	
	Drlg 2747'	
9/18	Viola 3158-	
	TD 3162'	
	5" @ 3158 RUST	
9/24	"	"
10/1	"	"
10/8	"	"
10/15	"	"
10/23	Viola 3158'	
	5" @ 3158'	
	500 Acid	
	TD 3173'	
	Pump 351 POT	
	Gr. 37	


COMPLETED

KANSAS

Kansas Pool Name Battle HillMap No. 42 Sec. 15 Twp. 18 R. 1WWell No. 7 SchultzAnderson & Prichard Company**FIRST REPORT**

Contractor

C N L NE NW

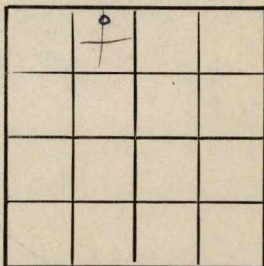SECTION PLAT330 Ft. from N. Line Ft. from S. Line660 Ft. from E. Line Ft. from W. LineMcPherson CountyLocation XRig up Drilling and Remarks: **RECORD**Cased in., ft.Sand Gas Oil Total Depth **PRODUCTION**1st 24 hrs. Nat. 1st 24 hrs. after shot Gas Cu. Ft.Dry Hole Abandoned

Date

AUG 28 1946 19S. J. LEWIS Scout

Kansas

KANSAS

Map No. 42 Sec. 15 Twp. 18 R. 1WWell No. 7 SchulzAnderson & Prichard Company**COMPLETED**

Contractor

C N L NE NW

21,139**SECTION PLAT**330 Ft. from N. Line

Ft. from S. Line

660 Ft. from E. Line

Ft. from W. Line

	6		

McPherson County

Location

Rig up

Drilling and Remarks:

10 to 31585" @ 3158.500 acialPump. 3515837° 4'**RECORD**

Cased _____ in., _____ ft.

Sand _____

Gas _____

Oil _____

Total Depth 3173**PRODUCTION**

1st 24 hrs. Nat. _____

1st 24 hrs. after shot _____

Gas _____ Cu. Ft.

Dry Hole _____

Abandoned _____

Date

OCT 23 1946 19S. J. LEWIS

Scout