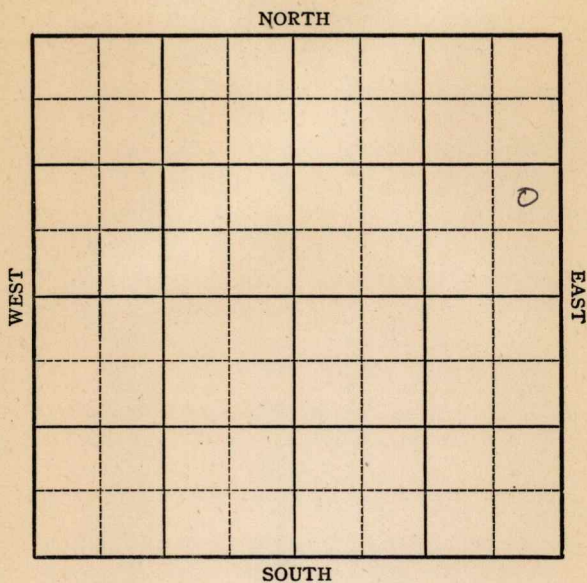


Section 1 Township 18 Range 2WWell No. #2 RobinsonCompany Derby Oil et al

KANSAS McPherson

Sec. 1 Twp. 18 R. 2W

Well No. #2 Robinson Farm

Derby Oil et al


Hoffsommer Pool (Carey, Drlg.) Company

 Ft. from N. Line

990' Ft. from S. Line

330' Ft. from E. Line

 Ft. from W. Line

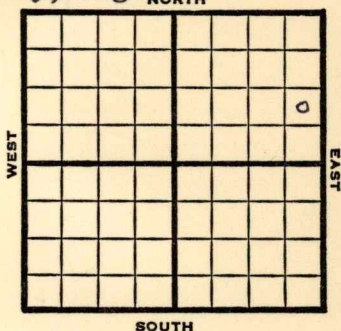

NE SE NE

1949

Elev 1409'

R E P O R T

12/7 8" @ 131'

12/14 Miss 2787
Drlg. 2792'

12/21 TD 2792'
5"@ 2789'

12/28 1050' oil / 300' W 14 hrs.

1950

2/1 TD 2792'

8"@ 131'

5"@ 2789'

Lans 2190'

Miss 2787'

P 51 BOPD

7% wtr.

Comp

COMPLETED

Kansas

Hoffsommer Pool

Map No. _____ Sec. 1 Twp. 18 R. 2WWell No. 2 Robinson

Derby Oil etal. _____ Company

Carey _____ Contractor


NE SE NE

FIRST REPORT
SECTION PLAT

_____ Ft. from N. Line

990 Ft. from S. Line330 Ft. from E. Line

_____ Ft. from W. Line

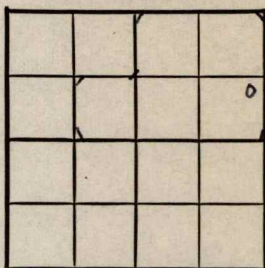

McPherson County

Location _____

Rig up _____

Drilling and Remarks: _____

8" @ 131

RECORD

Cased _____ in., _____ ft.

Sand _____

Gas _____

Oil _____

Total Depth _____

PRODUCTION

1st 24 hrs. Nat. _____

1st 24 hrs. after shot _____

Gas _____ Cu. Ft.

Dry Hole _____

Abandoned _____

Date

DEC 7 1949 19

S. J. LEWIS

Scout

Kansas

Map No. _____ Sec. 1 Twp. 18 R. 2WWell No. 2 Robinson

Derby Oil et al.

Company

Contractor

NE SE NE

E. 1409

SECTION PLAT

_____ Ft. from N. Line

990 Ft. from S. Line330 Ft. from E. Line

_____ Ft. from W. Line

COMPLETE			
			o

McPherson County

Location _____

Rig up _____

Drilling and Remarks:

8" @ 1315' @ 2789Loss 2190miss 2787P 51 BOPD7% water

RECORD

Cased _____ in., _____ ft.

Sand _____

Gas _____

Oil _____

Total Depth 2792

PRODUCTION

1st 24 hrs. Nat. _____

1st 24 hrs. after shot _____

Gas _____ Cu. Ft.

Dry Hole _____

Abandoned _____

Date

FEB 1 1950

19

J. E. TYRA

Scout