


Section 1 Township 18 Range 2W

Well No. #5 Robinson

Company Derby & Carrey

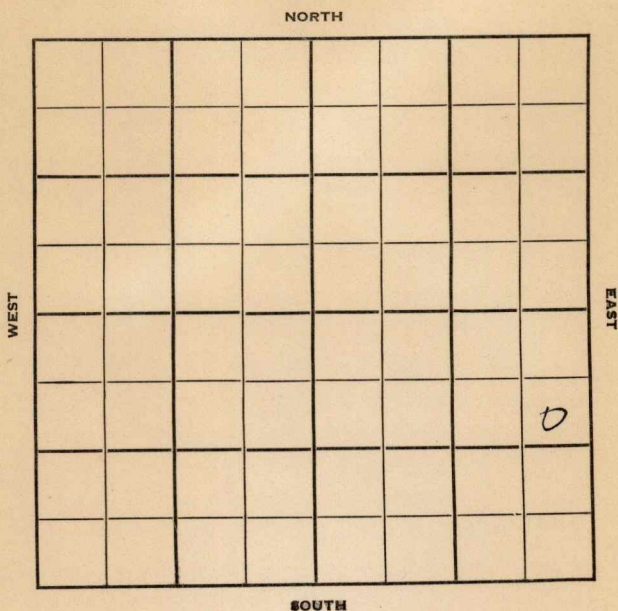

McPherson

KANSAS

Sec. 18 Twp. 18 R. 2W

Well No. #5 Robinson Farm

Derby & Carrey

Company

Carey Contr.

Contractor


990' Ft. from N. Line

Ft. from S. Line

330' Ft. from E. Line

Ft. from W. Line

SE NE SE

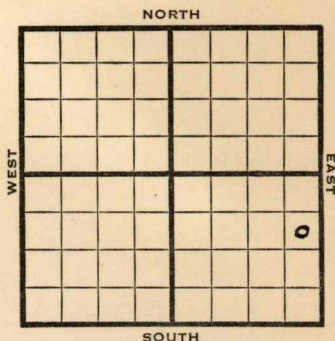

1950

Elev. 1414' REPORT

8/23 MIM

10/18

Spud 8-23-50

Oil Well TD 2796

8-5/8" @ 136' Miss 2793

TD 2796' 5 1/2" @ 2793

S/1 1/2 BOPH 500 A S/8 BOPH

S/27 BO 15 BW 3 hr.

Comp. 306 BOPD 15% wtr.

COMPLETED

County McPherson State KansasSec. 1 (Blk.) 18 (Sur.) 2W Map No.Operator Derby & CarreyWell No. 5 Farm RobinsonElev. Location SE NE SE

FIRST REPORT

0

990 Ft. From N Line SE330 Ft. From E Line Quarter1st. Report AUG 23 1950

Completion


Remarks

Spudding Date

Drlg. Data

M I M

J. E. TYRA

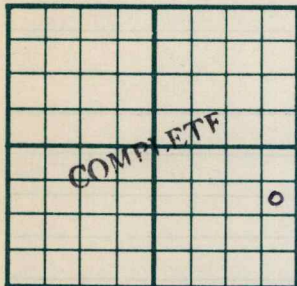County McPherson State KansasSec. 1 (Blk.) 18 (Sur.) 2W Map No.Operator Derby & CareyWell No. 5 Farm RobinsonElev. 1414 Location SE NE SE990 Ft. From N Line SE330 Ft. From E Line Quarter

1st. Report

Completion OCT 18 1950Remarks Georob PoolCarey - Contr.Spudding Date 8-23-50Drlg. Data Oil well TD 27968 5/8" @ 136 Miss. 2793 TD 27965 1/2" @ 2793 S/ 1 1/2 boph 500 A S/ 8 bophS/ 27 bo 15 bw 3 hr.Comp. 306 bopd 15% water

J. E. TYRA