


KANSAS

Section 2 Township 18 Range 2WWell No. #1 Lindberg.Company Isern & Lindas.

NORTH

WEST

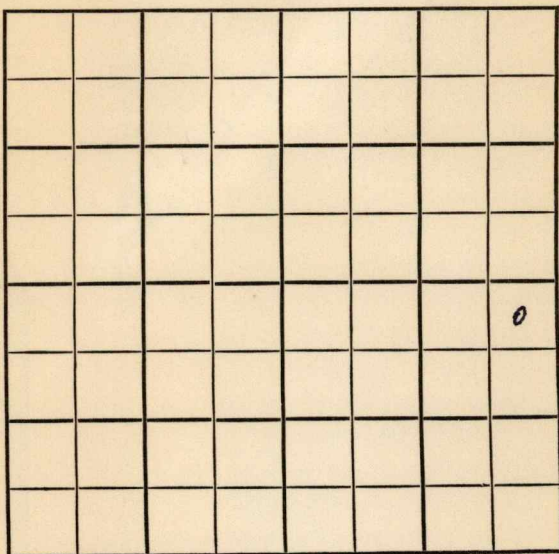

EAST

SOUTH

McPherson KANSAS

SEC.	TWP.	R.
2	18	2W

WELL NO.

1 Lindberg

FARM

COMPANY

Isern & Lindas

CONTRACTOR

Mallard

Georob Pool


330 Ft. from N. Line

Ft. from S. Line

330 Ft. from E. Line

Ft. from W. Line

NE NE SE

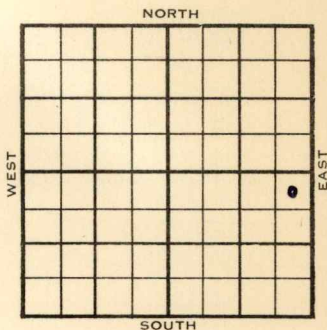

1955

ELEVATION

1405'

REPORT

1/19

MIR

2/2

Spud 1-19-55

8" @ 131'

KC 2204'

TD 2872'

D & A

ABANDONED

Kanab

2

Isern & Lindas

1

NE NE SE

FIRST REPORT

330

330

JAN 19 1955

1st. Report

Completion

Remarks

Mallard - Contr.


Spudding Date _____

Drig. Data

Georob Pool

M I R

FABEN GILSTRAP

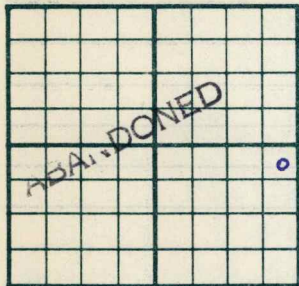County McPherson State KansasSec. 2 (Blk.
Twp.) 18 (Sur.
Rge.) 2W Map No.Operator Isern & LindasWell No. 1 Farm LindbergElev. 1405 Location NE NE SE330 Ft. From N Line SE330 Ft. From E Line Quarter1st. ReportCompletion FEB 2 1955Remarks Georob PoolMallard - Contr.Spudding Date 1-19-55

Drlg. Data

8" @ 131 KC 2204 TD 2872 D & A

FABEN GILSTRAP