

Map No. _____ Sec. 16 Twp. 21 R. 3w

Well No. 4-3000 Farm _____


Stanolind-Amradat Company

Noble

NORTH

WEST

EAST

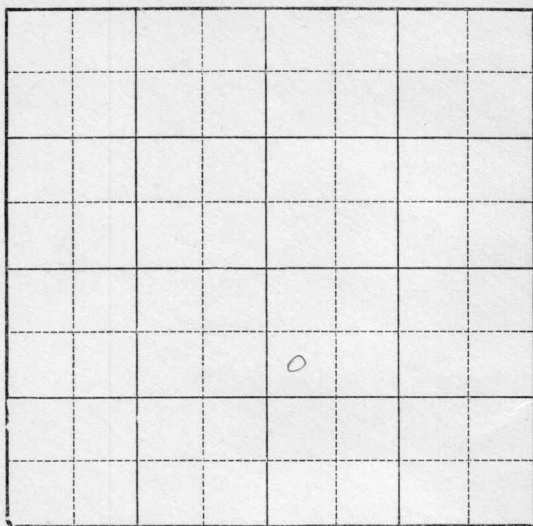

SOUTH

OWN

Location _____
Drilling Remarks _____

Rig Up _____
Drilling Remarks _____

RECORD
Cased _____ in. _____ ft.
Sand _____
Gas _____
Oil _____
Total Depth _____

PRODUCTION
1st 24 hrs. Nat. _____
1st 24 hrs. after shot _____
Gas _____ cu. ft.
Dry Hole _____
Abandoned _____

Map No. KANSAS Sec. 16 Twp. 21 R. 3^w

Well No. 4-3000 Farm


Stanolind - Amerasia Company
& Noble

990 Ft. from N. Line

_____ Ft. from S. Line

_____ Ft. from E. Line

330 Ft. from W. Line

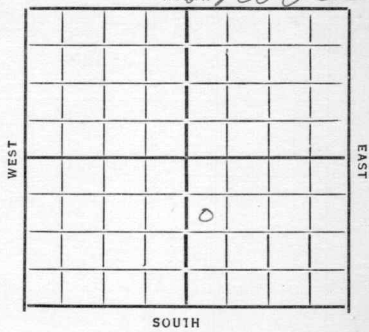

1932

Date	REPORT
11/29	<i>Log</i>
12/7	<i>1905</i>
12/14	_____
12/21	_____
12/28	_____
1933	_____
1/4	_____
1/11	<i>Bldg rig</i>
1/18	<i>set 190 ft sur pipe</i>
1/25	<i>15'-190</i>
	<i>Drlg 2471</i>
2/1	<i>Top Chat 3032</i>
	<i>Base line 3094</i>
	<i>Drlg 3169'</i>
2/8	<i>Viola 3360-72</i>
	<i>TD 3372' Rust</i>
2/15	<i>Cem 6"- 3366</i>
	<i>Wilcox 3380-3405</i>
	<i>TD 3405</i>
	<i>swab 378 bbl 22 hr</i>
	<i>(over)</i>

2/22- T.D. 3405
shot 10 qt 3390-96
No test
3/21 Pump 398 bbls 21 hrs
3/8 6"-3366'
Wilcox 3380-3405'-T.D.
shot 10 qt 3390' 3396'
Pump 474 BBLs
24 hrs.
Completed.

1933

OWD

5/31- Drilling Deeper

6/8 Silicious lime 3446 T.D. 3449 1/2
swab 759 bbls 17 hrs

6/15 30 bbls on pump

6/13- Top Silicious lime 3446-49 1/2
590 bbls oil
20 bbls water

COMPLETED

McPherson

43 KANSAS Map No. Sec. 16 Twp. 21 R. 3 W

Well No. 4 Zenger
Stanlines, Amerasia & Hable Company

Contractor

FIRST REPORTS

SECTION PLAT

990 Ft. from N. Line

Ft. from S. Line

Ft. from E. Line

330 Ft. from W. Line

Location ✓

Rig up

Drilling and Remarks:

RECORD

Cased in, ft.

Sand

Gas

Oil

Total Depth

PRODUCTION

1st 24 hrs. Nat.

1st 24 hrs. after shot

Gas Cu. Ft.

Dry Hole

Abandoned

Date

NOV 30 1932

CHAS. L. SHERWOOD

192

Scout

McPherson

43 KANSAS

Map No. Sec. 16 Twp. 21 R. 3^W

Well No. 4 Zenger

Stanolind, Amerasia, Kable Company

Contractor

COMPLETED

SECTION PLAT

990 Ft. from N. Line

Ft. from S. Line

Ft. from E. Line

330 Ft. from W. Line

Location

Rig up

Drilling and Remarks:

Shot 10/3390-95

Pump 474 Bbl
24 Hrs.

RECORD

Cased 1 1/2 in., 3366 ft.

Sand 3380-3405

Gas

Oil

Total Depth 3405

PRODUCTION

1st 24 hrs. Nat.

1st 24 hrs. after shot

Gas Cu. Ft.

Dry Hole

Abandoned

Date

MAR 8 1933

CHAS. L. SHERWOOD

192

Scout

KANSAS

McPherson
 Map No. *43* Sec. *16* Twp. *21* R. *3W*
 Well No. *4 - Zurgur*
Stanolind - Amerada Company

Contractor

*SW NW SE*FIRST REPORTS
SECTION PLAT

990 Ft. from N. Line

Ft. from S. Line

Ft. from E. Line

330 Ft. from W. Line

Location

Rig up

Drilling and Remarks:

*O.T. D. 34 22**R.W. to deepen*

RECORD

Cased.....in.,ft.

Sand.....

Gas.....

Oil.....

Total Depth.....

PRODUCTION

1st 24 hrs. Nat.....

1st 24 hrs. after shot.....

Gas.....Cu. Ft.

Dry Hole.....

Abandoned.....

Date

5/31/33 192 *O. Manschreck* Scout

Mepherson
 Map No. *43* Sec. *16* Twp. *21* R. *3W*

Well No. *4 - Jurgas*
Stanolind-Lmerada Company

Contractor

SECTION PLAT

990 Ft. from N. Line

..... Ft. from S. Line

..... Ft. from E. Line

330 Ft. from W. Line

COMPLETED

		0	

Location.....

Rig up.....

Drilling and Remarks:

siliceous shale
3446-49½

590 oil
20 water

RECORD

Cased..... in., ft.

Sand.....

Gas.....

Oil.....

Total Depth *3449½*

PRODUCTION

1st 24 hrs. Nat.....

1st 24 hrs. after shot.....

Gas..... Cu. Ft.

Dry Hole.....

Abandoned.....

Date

4/13/33 192 *Caval Marshback* Scout