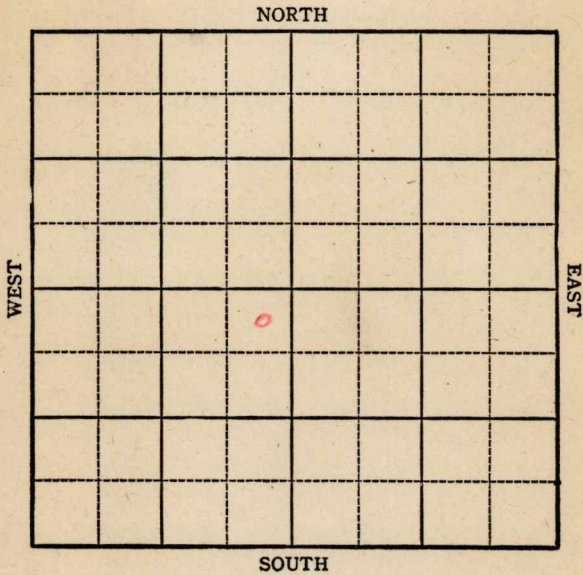


**KANSAS**

FORM 51 5M BRIX

Section 14 Township 18 Range 2WWell No. #1, NogensonCompany Phil-Han

KANSAS

McPherson

Sec. 14 Twp. 18 R. 2W


Well No. #1, Nogenson Farm  
Phil-Han Company

330 Ft. from N. Line

       Ft. from S. Line

330 Ft. from E. Line

       Ft. from W. Line

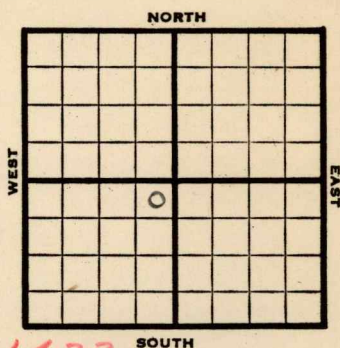

*Elev. 1433*

1944

REPORT

|      |           |
|------|-----------|
| 6/7  | Rotary    |
| 6/15 | 100' SD   |
| 6/21 | " "       |
| 7/5  | Lans 2163 |
|      | Miss 2874 |
|      | TD 2905   |

ABANDONED

Pool Name WildcatMap No. 42 Sec. 14 Twp. 18 R. 2WWell No. 1 NogensonPhil-Han

Company

## FIRST REPORT

Contractor

NE SW


## SECTION PLAT

330 Ft. from N. Line

Ft. from S. Line

330 Ft. from E. Line

Ft. from W. Line

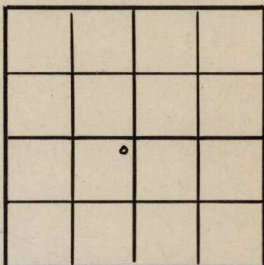McPherson County

Location

Rig up

Drilling and Remarks:

Rotary

## RECORD

Cased \_\_\_\_\_ in., \_\_\_\_\_ ft.

Sand \_\_\_\_\_

Gas \_\_\_\_\_

Oil \_\_\_\_\_

Total Depth \_\_\_\_\_

## PRODUCTION

1st 24 hrs. Nat. \_\_\_\_\_

1st 24 hrs. after shot \_\_\_\_\_

Gas \_\_\_\_\_ Cu. Ft.

Dry Hole \_\_\_\_\_

Abandoned \_\_\_\_\_

Date

JUN 7 1944 19S. J. LEWIS Scout

Pool Name WildcatMap No. KANSAS Sec. 14 Twp. 18 R. 2WWell No. 1 NogensonPhil-Han CompanyABANDONED Contractor

NE SW

## SECTION PLAT

|  |   |  |  |
|--|---|--|--|
|  |   |  |  |
|  |   |  |  |
|  | o |  |  |
|  |   |  |  |

330 Ft. from N. Line         Ft. from S. Line330 Ft. from E. Line         Ft. from W. LineMcPherson CountyLocation                         Rig up                         

Drilling and Remarks:

Land 2163Misc 2874

## RECORD

Cased                  in.,                  ft.Sand                         Gas                         Oil                         Total Depth 2905

## PRODUCTION

1st 24 hrs. Nat.                         1st 24 hrs. after shot                         Gas                          Cu. Ft.Dry Hole                         Abandoned                         

Date

JUL 5 1944 19 S. J. LEWIS Scout