

**KANSAS**


FORM 51 5M PETROL

McPherson

Section 15 Township 18 Range 1W

Well No. #3 Schulz

Company Anderson & Prichard

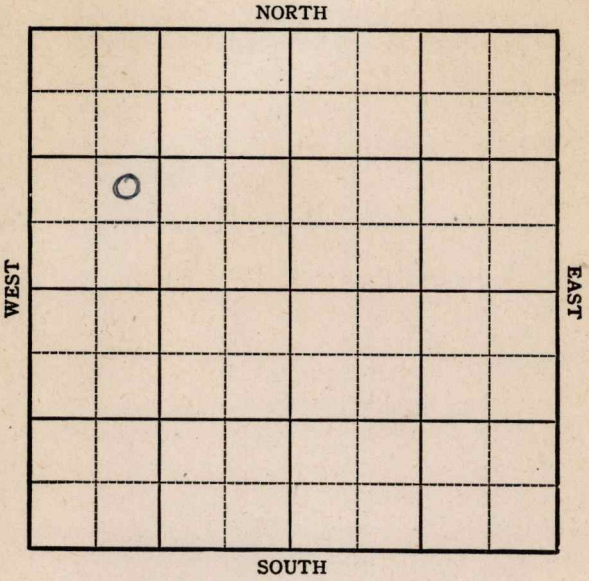

**KANSAS**

McPherson

Sec. 15 Twp. 18 R. 1W

Well No. #3 Schulz Farm  
Anderson & Prichard Company

Baden


\_\_\_\_\_ Ft. from N. Line

990 Ft. from S. Line

\_\_\_\_\_ Ft. from E. Line

990 Ft. from W. Line

*Elev. 1390*

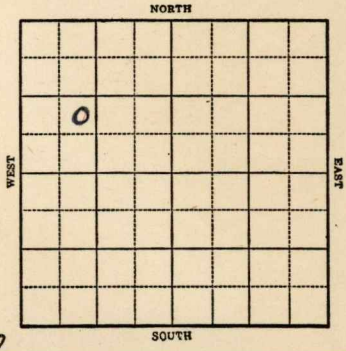

R E P O R T

1944

- 3/8 8" @ 184  
Drilling @ 1275'
- 3/16 Miss 2676-78 TD  
5" @ 2678  
Rust
- 3/22 TD 2701'  
Swb 20 oil per hr 3 hrs.
- 3/29 TD 2704 swb 20" oil per hr 2 hrs.
- 4/5 " " " " "
- 4/12 " " "
- 4/19 " " "
- 4/26 " " "
- 5/3 " "
- 5/10 Pump 25 oil in 14 hrs
- 5/17 Miss. 2676  
5" - 2678  
Pump 334 Pot.  
Gravity 38.8  
Total Depth 2704

**COMPLETED**

Map No. 2 Sec. 15 Twp. 18 R. 1W

Well No. 3 Schulz

Anderson & Prichard Company

FIRST REPORT Contractor

NE SW NW

SECTION PLAT

\_\_\_\_\_ Ft. from N. Line

990 Ft. from S. Line

\_\_\_\_\_ Ft. from E. Line

990 Ft. from W. Line

	o		

Baden Pool

Location \_\_\_\_\_

Rig up \_\_\_\_\_

Drilling and Remarks:

8" - 184

1275'

RECORD

Cased \_\_\_\_\_ in., \_\_\_\_\_ ft.

Sand \_\_\_\_\_

Gas \_\_\_\_\_

Oil \_\_\_\_\_

Total Depth \_\_\_\_\_

PRODUCTION

1st 24 hrs. Nat. \_\_\_\_\_

1st 24 hrs. after shot \_\_\_\_\_

Gas \_\_\_\_\_ Cu. Ft.

Dry Hole \_\_\_\_\_

Abandoned \_\_\_\_\_

Date

MAR 8 1944 19

S. J. LEWIS Scout

**KANSAS**

Pool Name Baden

Map No. 15 Sec. 18 Twp. 1W


Well No. 3 Schulz

Anderson & Prichard Company

**COMPLETED** Contractor

NE SW NW

**SECTION PLAT**

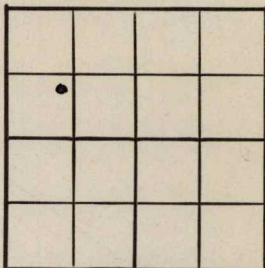

990 Ft. from N. Line

990 Ft. from S. Line

990 Ft. from E. Line

990 Ft. from W. Line

McPherson County

Location \_\_\_\_\_

Rig up \_\_\_\_\_

Drilling and Remarks:

*Mis 2676*  
*5' @ 2678*  
*Pump 334 P.D.*

*385 G*

**RECORD**

Cased \_\_\_\_\_ in., \_\_\_\_\_ ft.

Sand \_\_\_\_\_

Gas \_\_\_\_\_

Oil \_\_\_\_\_

Total Depth 2704

**PRODUCTION**

1st 24 hrs. Nat. \_\_\_\_\_

1st 24 hrs. after shot \_\_\_\_\_

Gas \_\_\_\_\_ Cu. Ft.

Dry Hole \_\_\_\_\_

Abandoned \_\_\_\_\_

Date

MAY 17 1944 19

S. J. LEWIS Scout