

KANSAS

FORM 51 25M 3-49 PETROL

McPherson


Section 1 Township 18 Range 2-W

Well No. #4 Robinson

Company Derby Oil & Carrie

NORTH

WEST

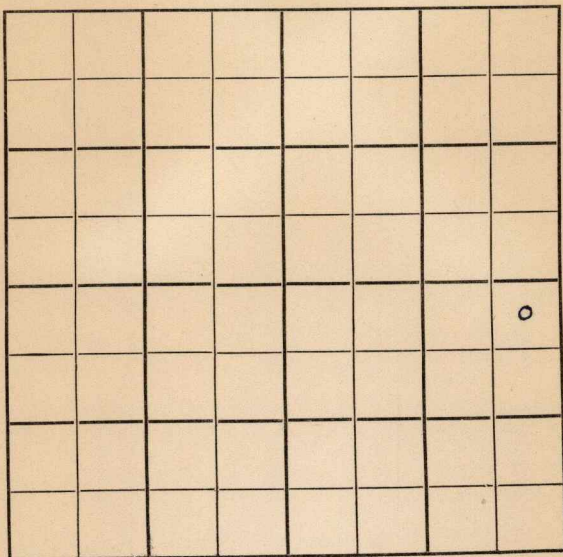

EAST

SOUTH

McPherson

KANSAS

Sec. 1 Twp. 18 R. 2W

Well No. #4 Robinson Farm

Derby Oil & Carrie Company

Contractor

Gerog Pool


330' Ft. from N. Line

Ft. from S. Line

330' Ft. from E. Line

Ft. from W. Line

NE NE SE

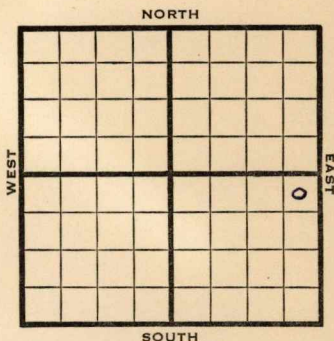

1950 Elev 1407

REPORT

7/5 Spud 7-3-50
Drlg.

8/16 8 5/8" @ 130
Miss 2777-81
5" @ 2778

TD 2781 FU 1000' oil 12 hr S/2 boph
500 A S/8 1/2 boph 2 hr
Comp 244 bopd 39% wtr
Completed

COMPLETED

Map No. _____ Sec. 1 Twp. 18 R. 2WWell No. 4 Robinson

_____ Derby Oil & Carrie _____ Company

_____ Contractor

NE NE SE

SECTION PLAT

330 Ft. from N. Line

_____ Ft. from S. Line

330 Ft. from E. Line

_____ Ft. from W. Line

McPherson County

Location _____

Rig up _____

Drilling and Remarks:

Spud 7-3-50

drlg.

RECORD

Cased _____ in., _____ ft.

Sand _____

Gas _____

Oil _____

Total Depth _____

PRODUCTION

1st 24 hrs. Nat. _____

1st 24 hrs. after shot _____

Gas _____ Cu. Ft.


Dry Hole _____

Abandoned _____

Date

JUL 5 1950 19J. E. TYRA Scout

County McPherson State Kansas
 Sec. 1 (Blk.) 18 (Sur.) 2W Map No.
 Operator Derby Oil & Carrie
 Well No. 4 Farm Robinson
 Elev. 1407 Location NE NE SE

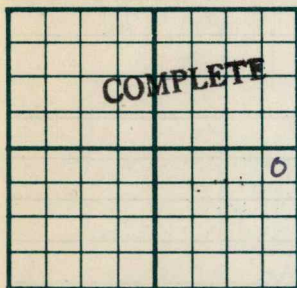

330 Ft. From N Line SE
330 Ft. From E Line Quarter

1st. Report

Completion AUG 16 1950

Remarks

Spudding Date 7-3-50

Drlg. Data Oil well TD 2781
8 5/8" @ 130 Miss. 2777-81 5" @ 2778
TD 2781 FU 1000' oil 12 hr. S/ 2 boph
500 A S/ 8 1/2 boph 2 hr.
Comp. 244 bopd 39% water

J. E. TYRA