

Form 51—5M—11-31—Palace

Map No. KANSAS Sec. 10 Twp. 21 R. 7

Well No. 5-21546 Farm _____

NORTH *and Noble*

WEST

EAST

SOUTH

NORTH

0

Location

Drilling Remarks

Rig Up_____

Drilling Remarks

RECORD

Cased _____ in. _____ ft.

Sand

Gas

Oil

Total Depth

PRODUCTION

1st 24 hrs. Nat. _____

1st 24 hrs. after shot.....

Gas cu. ft.

Dry Hole_____


Abandoned_____

Map No. KANSAS Sec. 16 Twp. 21 R. 3^w

Well No. 3- Zenger Farm

Stanford & Amurade Company
and Noble

NORTH

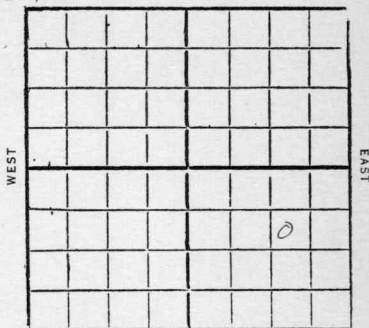

990 Ft. from N. Line

_____ Ft. from S. Line

990 Ft. from E. Line

_____ Ft. from W. Line

SOUTH

Date

REPORT

8/31	Loc
9/7	—
9/14	—
9/21	—
9/30	—
10/5	—
10/12	Rig
10/19	Cem 15"-187'
10/26	Drilg 24 20'
11/2	Top Chat 3035
11/9	Cem 8"-3045' Rust
11/16	—
11/23	TD 3060
	Est 30 bbl per hr
	8 to 9 ft gas
11/30	Cased 8"-3045
	Chat 3035-60'
	TD 3060
	flow 22 1/2 bbl per hr.
	420# b.p.
	Comp.

43 KANSAS

McPherson

Map No. Sec. 16 Twp. 21 R. 3^W

Well No. 3 Zenger

Stanolind, Amerada-Noble Company

..... Contractor

FIRST REPORTS

990 Ft. from N. Line

..... Ft. from S. Line

990 Ft. from E. Line

..... Ft. from W. Line

SECTION PLAT

			0

Location..... ✓

Rig up.....

Drilling and Remarks:

RECORD

Cased..... in., ft.

Sand.....

Gas.....

Oil.....

Total Depth.....

PRODUCTION

1st 24 hrs. Nat.....

1st 24 hrs. after shot.....

Gas..... Cu. Ft.

Dry Hole.....

Abandoned.....

Date

192.....

Scout

McPherson

W

43 KANSAS

Map No. _____ Sec. 16 Twp. 21 R. 3

Well No. 3 Zenger

Stanolind Amerasia & Noble Company

Contractor

COMPLETED

SECTION PLAT

			o

990 Ft. from N. Line

_____ Ft. from S. Line

990 Ft. from E. Line

_____ Ft. from W. Line

Location _____

Rig up _____

Drilling and Remarks:

flow 22 1/2 Bbl
Per hour.
420 # B.P.

RECORD

Cased 8 in., 3045 ft.

Sand Chert 3035-3060

Gas _____

Oil _____

Total Depth 3060

PRODUCTION

1st 24 hrs. Nat. _____

1st 24 hrs. after shot _____

Gas _____ Cu. Ft.

Dry Hole _____

Abandoned _____

Date

NOV 30 1932

CHAS. L. SHERWOOD

192

Scout