

Map No. _____ Sec. 21 Twp. 21 R. 3
Well No. 1-David Pick Farm _____
Rose Spring Dry & Cheese Company _____

WEST

EAST

SOUTH

Drilling Remarks

Drilling Remarks

Cased _____ in. _____ ft.
 Sand _____
 Gas _____
 Oil _____
 Total Depth _____


1st 24 hrs. Nat.
1st 24 hrs. after shot
Gas cu. ft.
Dry Hole
Abandoned

Map No. KANSAS Sec. 21 Twp. 21 R. 3^w

Well No. 1-David Dick Farm

Rose Spring Dredge & Shell Company

NORTH

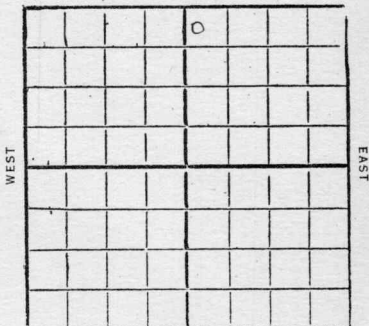

330 Ft. from N. Line

_____ Ft. from S. Line

_____ Ft. from E. Line

165 Ft. from W. Line

1932

SOUTH

Date

REPORT

10/5	Loc
10/12	
10/19	Rigs
10/26	Rgn up
11/2	12"-200'
	dreg 1390'
11/9	" 2600'
11/16	Chat 3080
	Base line 3140
	dreg 3300'
11/23	Top Viola 3385
	Cem 8"-3390' Rust
11/30	6"-3390 Wilcox 3436
	show oil 3446-51
	show water 3454-56
	swab 5 bbl fluid per hr
12/7	TD 3457
	swab 100 bbl oil and
	4 bbl water 8 hr
12/14	TD 3457
	shot 10 qt 3445-52
	Pump 280 bbl oil & 20 water a day

12/21- TD 3457' SD far Ph.

12/28 —

1933

1/4 —

1/11- Wilcox 3436-57

TD 3457

shot 10 qt 3445-52
pump 50 bbl per day
Comp.

Map No. 43 Sec. 21 Twp. 21 R. 3 ^W

Well No. 1 Davis Dick

Res. Spring Oil Co. & Shell Company

Contractor

FIRST REPORTS

SECTION PLAT

330 Ft. from N. Line

..... Ft. from S. Line

..... Ft. from E. Line

165 Ft. from W. Line

		0	

Location ✓

Rig up

Drilling and Remarks:

RECORD

Cased.....in., ...ft.

Sand.....

Gas.....

Oil.....

Total Depth.....

PRODUCTION

1st 24 hrs. Nat.....

1st 24 hrs. after shot.....

Gas.....Cu. Ft.

Dry Hole.....

Abandoned.....

Date

OCT 5 1932 192 CHAS. L. SHERWOOD Scout

43 KANSAS Map No. Sec. 21 Twp. 21 R. 3^W

Well No. 1 Davis Dick
Rose Spring & Sheel Company

Contractor

COMPLETED

SECTION PLAT

		0	

330 Ft. from N. Line

Ft. from S. Line

Ft. from E. Line

165 Ft. from W. Line

Location

Rig up

Drilling and Remarks:

Shot 10/3445-52

Pump 50 Res
Per Day

RECORD

Cased in., ft.

Sand Nulcor 3436-57

Gas

Oil

Total Depth 3457

PRODUCTION

1st 24 hrs. Nat.

1st 24 hrs. after shot

Gas Cu. Ft.

Dry Hole

Abandoned

Date

JAN 1 1 1933 CHAS. L. SHERWOOD

192 Scout