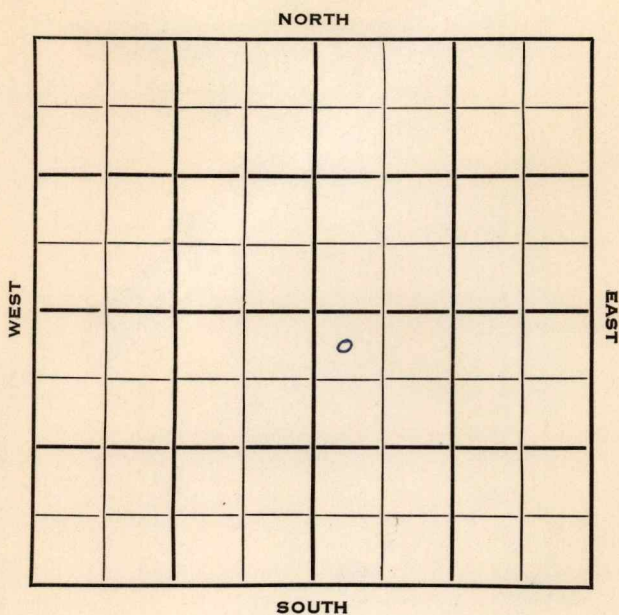


Section 12 Township 18 Range 2W

Well No. 1 Stuckey

Company Derby Oil & Welsh & Olson

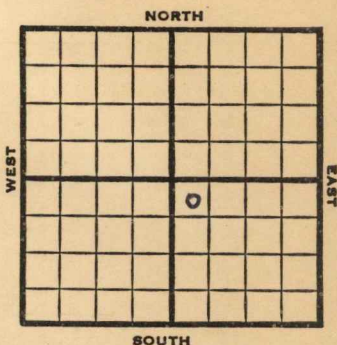


KANSAS ✓

McPherson

Sec. 12 Twp. 18 R. 2WWell No. 1 Stuckey FarmDerby Oil & Welsh & Olson CompanyWelsh & Olson - Contr. ContractorWildcat330 Ft. from N. Line Ft. from S. Line330 Ft. from E. Line Ft. from W. Line

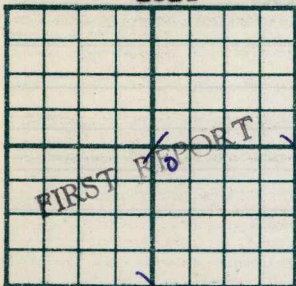
NW NW SE

1953 **1514 Elev.** REPORT

4/1 Spud 3-26-53
 8" @ 148
 Drlg 1995

4/8 Spud 3-26-53 D & A TD 2958'
 8" @ 148 Heeb 2075' Tor. 2088'
 Doug. 2103' Lans 2305' Miss. 2933'
 TD 2958' D & A

ABANDONED

County McPherson State KansasSec. 12 (Blk.) 18 (Sur.) 2W Map No. 18 (Twp.)Operator Derby Oil & Welsh & OlsonWell No. 1 Farm StuckeyElev. 1514 Location NW NW SE330 Ft. From N Line SE330 Ft. From W Line Quarter1st. Report APR 1 1953

Completion

Remarks

Welsh & Olson - Contr.Spudding Date 3-26-53Drlg. Data Wildcat8" @ 148 d-lg. 1995

J. G. McGEHEE

County McPherson State Kansas
 Sec. 12 (Blk.) 18 (Sur.) 2W Map No.
 Operator Derby Oil & Welsh & Olson
 Well No. 1 Farm Stuckey
 Elev. 1514 Location NW NW SE



330 Ft. From N Line SE
330 Ft. From W Line Quarter

1st. Report

Completion APR 8 1953

Remarks Wildcat

Welsh & Olson - Contr.

Spudding Date 3-26-53

Drlg. Data D & A TD 2958

8" @ 148 Heeb. 2075 Tor. 2088

Doug. 2103 Lans. 2305 Miss. 2933

TD 2958

D & A