

Section 12 Township 18 Range 2 WWell No. # 1 StuckyCompany Welsh & Ollson

0							

NORTH

WEST

EAST

SOUTH

McPherson

KANSAS ✓

Sec. 12 Twp. 18 R. 2W

Well No. #1 Stucky Farm

Welsh & Ollson Company

Eckland Contractor

Wildcat

Ft. from N. Line

330


Ft. from S. Line

Ft. from E. Line

330

Ft. from W. Line

SW SW SW

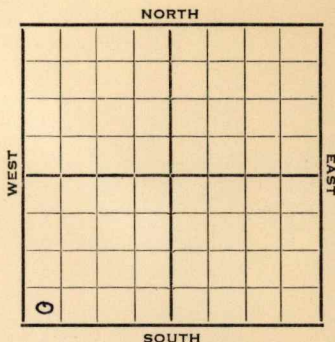

1952

Elev. 1462'

REPORT

6/25

Drlg.

7/2

8" @ 118

KC 2209

Drlg. 2580'

7/9

Spud 6-23-52

D & A TD 2920' 8" @ 118

KC 2209' Miss 2895'

TD 2920' D & A

ABANDONED

County **McPherson** State **Kansas**
 Sec. **12** (Blk.) **18** (Sur.) **2W** Map No.
 (Twp.) (Rge.)
 Operator **Welsh & Ollson**
 Well No. **1** Farm **Stucky**
 Elev. Location **SW SW SW**

FIRST REPORT

330 Ft. From **S** Line **SW**
330 Ft. From **W** Line Quarter

1st. Report **JUN 25 1952**

Completion

Remarks

Eckland - Contr.

Spudding Date

Drlg. Data

Wildcat

Drlg.

J. G. McGEHEE

J. G. McGEHEE