


Barton

Section 28 Township 20 Range 14W

Well No. #1 Reeves

Company Hinkle Oil

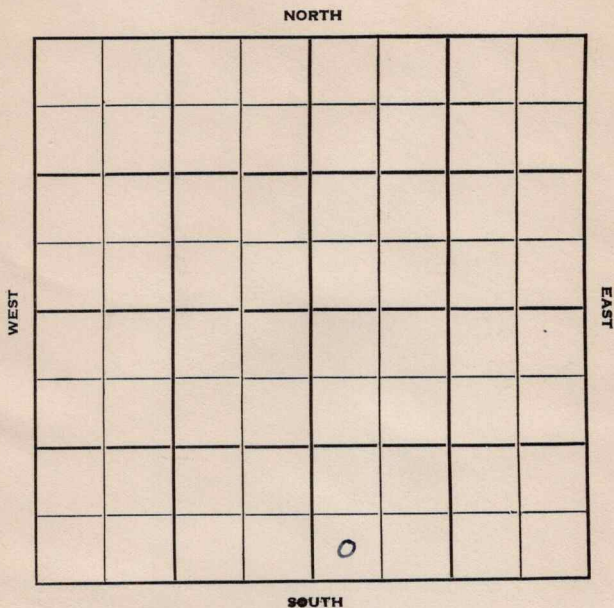

Barton
20

KANSAS

14W

Sec. 28 Twp. R. ✓

Well No. #1 Reeves Farm

Hinkle Oil Company

Hinkle Oil - Contr. Contractor

Wildcat

Ft. from N. Line

330'


Ft. from S. Line

Ft. from E. Line

330'

Ft. from W. Line

SW SW SE

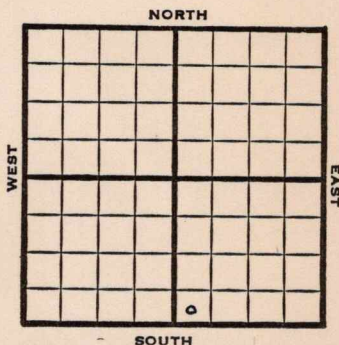

1950

Elv. 1909'

REPORT

12/6

Spud 12-4-50
Drlg. 402'

1951

1/10

Spud 12-4-50
D&A TD 3620

8" @ 840 Anhy 849 Lans. 3308

Cong. 3565 Arb. 3602-20 TD

DST 3602-20 opn 1 hr

Rec. 680' wtr

D&A

ABANDONED

County Barton

State Kansas

Sec. 28 (Blk.)
(Twp.)

20

(Sur.)
(Rge.)

14W

Map No.

Operator Hinkle Oil

Well No. **1** Farm **Reeves**

Elev.	Location	SW	SW	SE
-------	----------	----	----	----

FIRST REPORT

0

330 Ft. From S Line SE

330 Ft. From W Line Quarter

1st. Report DEC 6 1950

Completion

Remarks


Hinkle Oil - Contr.

Spudding Date 12-4-50

Drig. Data Wildcat

drlg. 402

J. E. TYRA

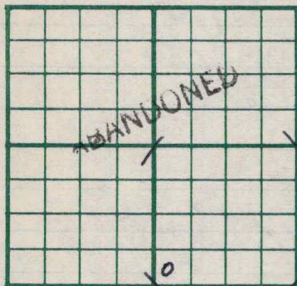County Barton State KansasSec. 28 (Blk.
Twp.) 20 (Sur.
Rge.) 14W Map No.Operator Hinkle OilWell No. 1 Farm ReevesElev. 1909 Location SW SW SE330 Ft. From S Line SE330 Ft. From W Line Quarter

1st. Report

Completion JAN 10 1951Remarks WildcatHinkle Oil - Contr.Spudding Date 12-4-50Drlg. Data D & A TD 36208" @ 840 Anhy 849 Lans. 3308 Cong.3565 Arb. 3602-20 TD DST 3602-20open 1 hr. Rec. 680' waterD & A

J. E. TYRA