


Section 29 Township 20 Range 14W

Well No. #1 Christianson

Company Isern Bros., Geo. Angle & Adkins Drlg.

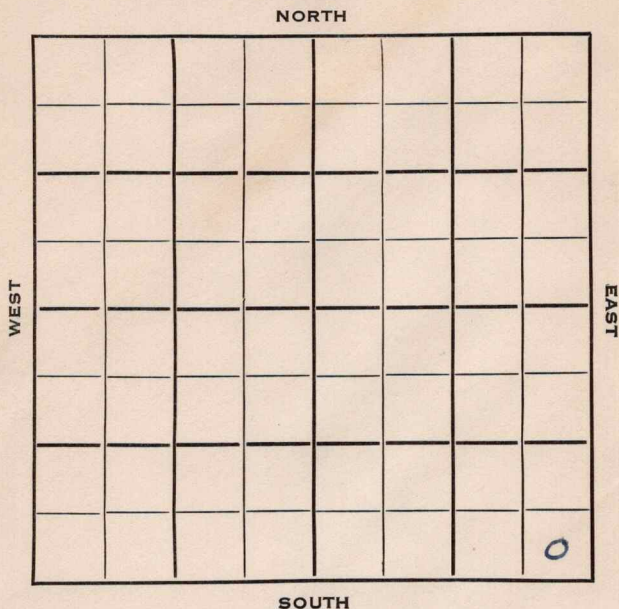


Barton

KANSAS

Sec. 29 Twp. 20 R. 14 WWell No. # 1 Christianson FarmIsern Bros. Geo Angle & CompanyAdkins Drlg.Adkins Drlg. ContractorWildcat Ft. from N. Line330 Ft. from S. Line330 Ft. from E. Line Ft. from W. Line

SE SE SE

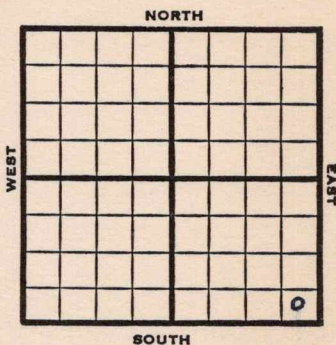

1953

Elev. 1916'

REPORT

5/6

Spud 5-1-53

8" @ 221' Anhy 865'

Drlg. 1782'

5/13

Spud 5-1-53

D & A

TD 3697'

8" @ 221'

Anhy 865, Heeb 3223, Br. Lime 3324,

Lans 3333, Simp 3661, Arb 3674.

TD 3697'

D & A.

ABANDONED

County Barton State Kansas
 Sec. 29 (Blk. 20 (Sur. 14W Map No.
 (Twp.) (Rge.)
 Operator Isern Bros., Geo. Angle & Adkins Dr.
 Well No. 1 Farm Christianson
 Elev. Location SE SE SE



330 Ft. From S Line SE
330 Ft. From E Line Quarter

1st. Report MAY 6 1953

Completion

Remarks

Adkins Drlg. - Contr.

Spudding Date 5-1-53

Drlg. Data

Wildcat

8" @ 221 Anhy 865 drlg. 1782

County Barton State Kansas
 Sec. 29 (Blk.) 20 (Sur.) 14W Map No.
 Operator Isern Bros., Geo. Angle & Adkins Drl
 Well No. 1 Farm Christianson
 Elev. 1916 Location SE SE SE



330 Ft. From S Line SE
330 Ft. From E Line Quarter

1st. Report

Completion MAY 13 1953

Remarks Wildcat

Adkins Drlg. - Contr.

Spudding Date 5-1-53

Drlg. Data D & A TD 3697

8" @ 221 Anhy 865 Heeb. 3223

Br. lime 3324 Lans. 3333 Simp. 3661

Arb. 3674 TD 3697

D & A