

KANSAS


Barton County

FORM 51 5M 11-44 PETROL

Section 29 Township 20 Range 14W

Well No. #1 Christianson

Company Champlin Ref.

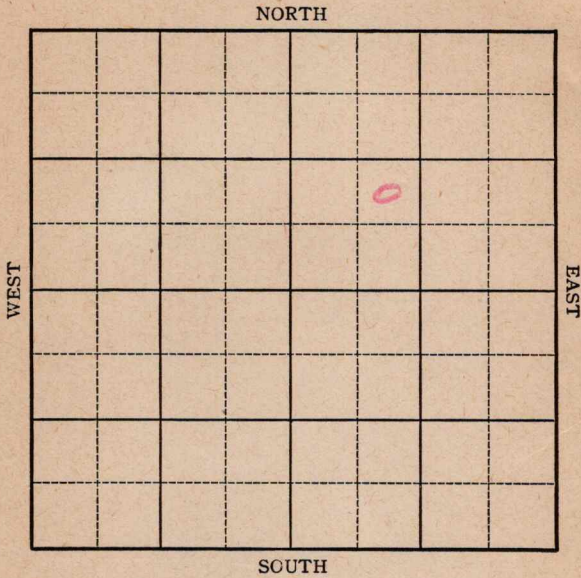

Sec. 29 Twp. 20 R. 14W

Well No. #1 Christianson Farm

Champlin Ref. Company


Wildcat

 Ft. from N. Line

990 Ft. from S. Line

 Ft. from E. Line

990 Ft. from W. Line

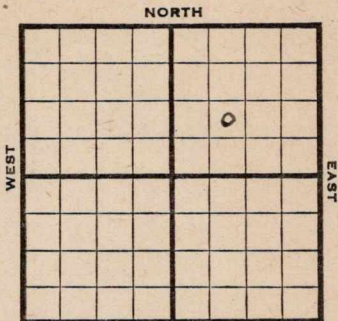

NE SW NE Elev. 1908

1945

R E P O R T

3/21	15" @ 30	WOC	
3/29	Shut down		
4/5	Drlg. 117		
4/12	Anhy		850
	8" @ 892		
	Drl . 2063		
4/20	Drlg. 3302		
4/27	Topeka		2880
	Lans		3313
	Arb		3606
	TD 3650		
	5" @ 3650'	RUST	
5/3	" "	" "	" "
5/10	" "	" "	" "
5/17	" "	" "	" "
5/23	Arb		3598
	5" @ 3650		
	TD 3650		
	36 shots 3601-3611		
	6 M Gas.		
	1010 R Pr.		

COMPLETED

Kansas Pool Name Wildcat

Map No. 82 Sec. 29 Twp. 20 R. 14^W

Well No. 1 Christianson

Champlin Ref. Company

COMPLETED

Contractor

NE SW NE

E, 1908
SECTION PLAT

		0	

_____ Ft. from N. Line

990 Ft. from S. Line

_____ Ft. from E. Line

990 Ft. from W. Line

Barton County

Location _____

Rig up _____

Drilling and Remarks:

CR 7 3598.

5" @ 3650

36 shot to 3601-11

6M. Gas

1010 R²

RECORD

Cased _____ in., _____ ft.

Sand _____

Gas _____

Oil _____

Total Depth 3650

PRODUCTION

1st 24 hrs. Nat. _____

1st 24 hrs. after shot _____

Gas _____ Cu. Ft.

Dry Hole _____

Abandoned _____

Date

MAY 23 1945

19

S. J. LEWIS

Scout