

M^cPherson


Form 51-5M-2-29-34703

Map No. **KANSAS** Sec. 21 Twp. 21 R. 3rd

Well No. 1- New field Farm

~~Western Gas & Oil~~ Company

All States Pet. Co. & Shell

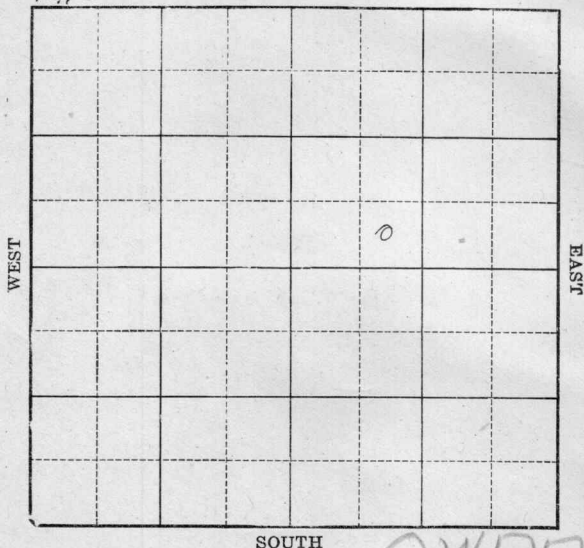

Location _____

Drilling Remarks _____

Rig Up _____

Drilling Remarks _____

RECORD

Cased _____ in. _____ ft.

Sand _____

Gas _____

Oil _____

Total Depth _____

PRODUCTION

1st 24 hrs. Nat. _____

1st 24 hrs. after shot _____

Gas _____ cu. ft.

Dry Hole _____

Abandoned _____

Map No. KANSAS Sec. 21 Twp. 21 R. 3^W

Well No. 1- Newclay Farm

~~Western Gas & Oil~~ Company

All States Pet. & Shell

NORTH


 Ft. from N. Line

330 Ft. from S. Line

 Ft. from E. Line

990 Ft. from W. Line

1932

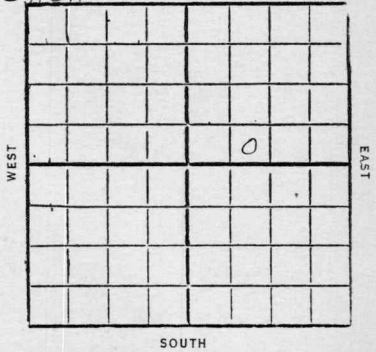

Date	REPORT
6/29	Slush pond
7/6	
7/13	
7/20	RUR
7/27	15"-209
	Dreg 600'
8/3	" 2044
8/10	TD 2558' Fishing
8/17	dreg 2558
8/24	Top chat 3087
	8"-3092
	SD 3093
8/31	TD 3093 Rust
	Old ock
9/7	First oil 3117
	Pay 3127-33
	TD 3140
	swab 180 bbl 5 hr
	400 ft off bottom
	show water
	38 ² grav
	(over)

9/14- TD 3140

Pump 490 bbl oil &
(est) 50 bbl water 24 hrs
373 graw.

9/21- TD 3140

pump 205 bbl oil
and 75 bbl water
in 18 hrs

9/30-

Cased 8" 3092

Chat 3087-3140

First oil 3117

Cue 3127-33

TD 3140

Pump 250 bbl oil
and 50 bbl water
Comp.

1932

OWDD

11/30- Oed TD 3140

R.U. to deepen

12/7- Base line 3225
show oil 3365

TD 3367 8 1/2" 6"

12/14- Top Hunton 3365'

Base " 3400'

Top Viola 3470

Base " 3489

show oil

Top Welcor 3492

Core 3496'

12/21- Had HFW 3502

TD 3512' Will plug back

12/28- TD 3512'

P.B. to 3130' To shoot 5 qt

Map No. Kansas Sec. 21 Twp 21 R. 3w

Well No. 1- Newfield Farm
All States & Spence Company


Ft. from N. Line

330 Ft. from S. Line

Ft. from E. Line

990 Ft. from W. Line

1933

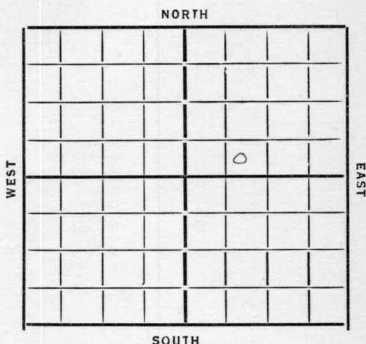

Date _____

REPORT

1/4

T17 3512

P.B. to 31.33 1/2'

Shat 5 yst. 3128-33

Plump 65 bol oil &

20 ppl water 8 hr

111

Chat 3087-3/40

Huntton 3365-3400

Viola 3470-89

Welcox 3492

TD 3512' HFW

P.B. to 3133 1/2

shot 5 qt 3128-33

Sum 65 gbl oil

and 24 pbl water

Comp.

KANSAS

Map No. _____ Sec. 21 Twp. 21 R. 3 ^WWell No. 1 NewfieldWestern Gas Co. & Shell Company

Contractor _____

FIRST REPORTS

_____ Ft. from N. Line

330 Ft. from S. Line

_____ Ft. from E. Line

990 Ft. from W. Line

SECTION PLAT

		o	

Location _____

Rig up Blush Pond

Drilling and Remarks: _____

RECORD

Cased _____ in., _____ ft.

Sand _____

Gas _____

Oil _____

Total Depth _____

PRODUCTION

1st 24 hrs. Nat. _____

1st 24 hrs. after shot _____

Gas _____ Cu. Ft.

Dry Hole _____

Abandoned _____

Date

JUN 29 1932

192

CHAS. L. SHERWOOD

Scout

43 KANSAS

Map No. _____ Sec. 21, Twp. 21 R. 3

Well No. 1

All States Pet Co. & Sheel Company

Contractor

CORRECTION

_____ Ft. from N. Line

330 Ft. from S. Line

_____ Ft. from E. Line

990 Ft. from W. Line

SECTION PLAT

		0	

Location _____

Rig up _____

Drilling and Remarks:

Ownership above.

Chg to

RECORD

Cased _____ in., _____ ft.

Sand _____

Gas _____

Oil _____

Total Depth _____

PRODUCTION

1st 24 hrs. Nat. _____

1st 24 hrs. after shot _____

Gas _____ Cu. Ft.

Dry Hole _____

Abandoned _____

Date

JUL 27 1932

CHAS. L. SHERWOOD

192

Scout

43 KANSAS McPherson
 Map No. _____ Sec. 21 Twp. 21 R. 3^W

Well No. 1 Newfield
 All States Oil & Shell Company

Contractor

COMPLETED

SECTION PLAT

_____ Ft. from N. Line

330 Ft. from S. Line

_____ Ft. from E. Line

990 Ft. from W. Line

Location _____

Rig up _____

Drilling and Remarks:

1st Oil 3117

Pay 31-17-33

Pump 250 Bbl

& 50 Bbl Water

RECORD

Cased 8 in., 309.7 ft.

Sand 3087-3140

Gas _____

Oil _____

Total Depth 3140

PRODUCTION

1st 24 hrs. Nat. _____

1st 24 hrs. after shot _____

Gas _____ Cu. Ft.

Dry Hole _____

Abandoned _____

Date

SEP 30 1932

192

CHAS. L. SHERWOOD

Scout

43 KANSAS

Map No. _____ Sec. 21 Twp. 21 R. 3

Well No. 1 Hempstead

all States Petroleum & Shell Company

Contractor

FIRST REPORTS


_____ Ft. from N. Line

330 Ft. from S. Line

_____ Ft. from E. Line

990 Ft. from W. Line

SECTION PLAT

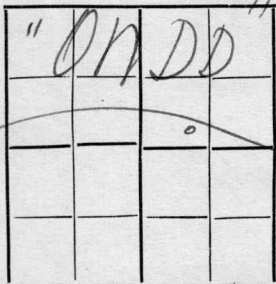

Location _____

Rig up _____

Drilling and Remarks:

Rigging up
to Deepen

RECORD

Cased 8 in., 3092 ft.
 Sand Chas 3087-3140
 Gas _____
 Oil _____
 Total Depth 3140

PRODUCTION

1st 24 hrs. Nat. _____
 1st 24 hrs. after shot _____
 Gas _____ Cu. Ft.
 Dry Hole _____
 Abandoned _____

Date

NOV 30 1932

192

CHAS. L. SHERWOOD

Scout

43 KANSAS Map No. Sec. 21 Twp. 21 R. 3

Well No. 1 Newfield

all States Oil & Shells Company

Contractor

COMPLETED

SECTION PLAT

		0	

Ft. from N. Line

330 Ft. from S. Line

Ft. from E. Line

990 Ft. from W. Line

Location

Rig up

Drilling and Remarks:

Hunter 3365-3400

Viola 3470-3489

Wilcox 3492 HFW 3502

P.B. 3133 1/2, Shat

5/3128-33

Pump 65 lbs oil
& 29 lbs Water

RECORD

Cased in. ft.

Sand Shat 3087-3140

Gas

Oil

Total Depth 3512

PRODUCTION

1st 24 hrs. Nat.

1st 24 hrs. after shot

Gas Cu. Ft.

Dry Hole

Abandoned

Date

JAN 11 1933

192

CHAS. L. SHERWOOD

Scout