
McPherson KANSAS

SECTION 21 TOWNSHIP 21S RANGE 3W

WELL NO. #1 Martens

COMPANY Veeder Supply

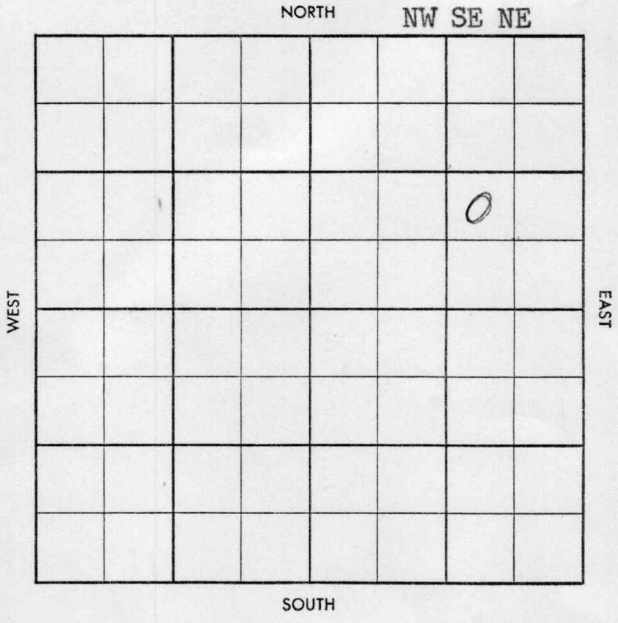

FORM 504-3 SUNRAY

S-513-B

County McPherson Elev.

Sec. 21 Twp. 21 Rge. 3W

Company Veeder Supply

Farm Name Martens No. 1

TOPS	DEPTH	LOG	DATUM
Anh.			
Tp.			
H.			
Tr.			
Dg.			
B. L.			
L.			
K.C.			
B.K.C.			
Ce.			
C.			
M.			
M.			
K.			
Mz.			
Mq.			
V.			
S.			
S.			
A.			
R.			
Pf.			
G.			
T.D.			

Loc. in Sec. NW SE NE

Geol.

Contr. Co. tools

Pool Voshell

APR 15 '58

FIRST REPORT

Date Comm. 4-11-58

8" @ 175 drlg. 1780

Co. Lse. No. Sec. T. R.

Roger E. Kolterman (7/1958)

Chermyuk 3-2

S-S13-B

County McPherson Elev. 1456 kB 1455 DF

Sec. 21 Twp. 21 Rge. 3W

Company Veeder Supply

Farm Name Martens No. 1

TOPS	DEPTH	LOG	DATUM
Anh.			
Tp.			
H.			
Tr.			
Dg.			
B.L.			
L.			
K.C.	2397		
B.K.C.			
Ce.			
C.			
M.	3076		
M.			
K.			
Mz.			
Mq.			
V.			
S.			
S.			
A.			
R.			
Pf.			
G.			
T.D.	3133		

Loc. in Sec. NW SE NE

Am Sokol

Geol. Jim Daniels

Contr. Co. tools

Pool Voshell

JUL 16 '58

0

COMPLETE

Date Comm. 4-11-58

8" @ 175 drlg. 1780 APR 23 '58 Tops

DST 3078-95 opl hr rec 130'

Hocm 60' Wtr M/tr oil FP 30-105

IBHP 570/30" NO FBHP 4" 3132

WOC APR 30 '58

MAY 7 '58 MAY 14 '58 LO 3098 29/3081

-87 #1680 + 20c BW 24 hrs

WOP MAY 21 '58 MAY 28 '58 TA WOPU

JUN 3 '58 JUN 11 '58 JUN 18 '58 JUN 25 '58 JUL 2 '58

FORM 513-1 SUNRAY

JUL 15 '58 P 18 BOPD + 10 + SW +-

M 3081-87

21-21-3W NW NE