

McPherson

Form 51-5M-5-34-Palace


Map No. **KANSAS** Sec. 21 Twp. 21 R. 3W

Well No. 2 Newfeldt Farm

Murphy et al. Company

NORTH

McKnabb et al

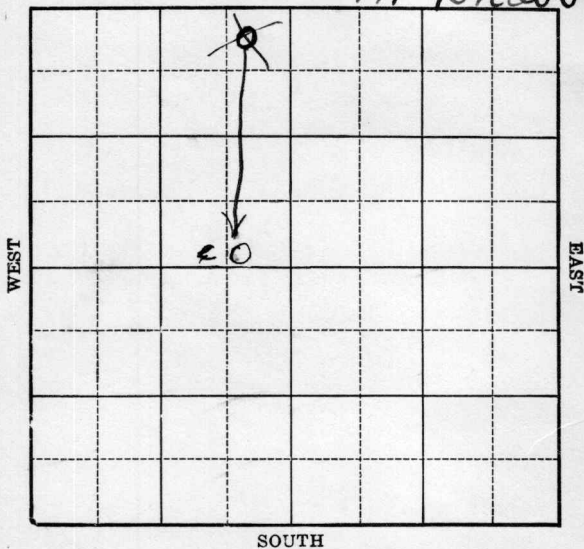

Location

Drilling Remarks

Rig Up

Drilling Remarks

RECORD

Cased _____ in. _____ ft.

Sand _____

Gas _____

Oil _____

Total Depth _____

PRODUCTION

1st 24 hrs. Nat. _____

1st 24 hrs. after shot _____

Gas _____ cu. ft.

Dry Hole _____

Abandoned _____

McPherson

Map No. KANSAS Sec. 21 Twp 21 R. 3 W


Well No. 2 Newfeldt Farm
Murphy et al McKnabb et al
Company

 Ft. from N. Line

330
~~330~~ Ft. from S. Line

641 Ft. from E. Line

 Ft. from W. Line

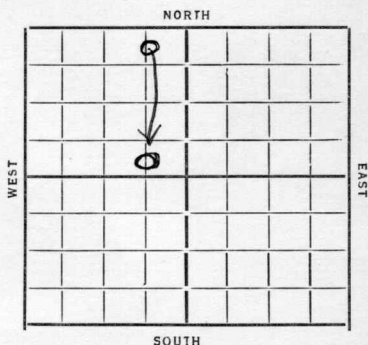

Date 1934

REPORT

OWDD

6/6	Bldg. Rot. Rig		
6/14	Rig		
6/31	6/28	7/5	—
7/12	7/19	7/26	—
8/2	8/9	8/16	—
8/23	8/30	9/6	—
9/12	abk. Location		

1934

ABANDONED

9/19	Dly 3305		
9/27	" 930		
10/4	1400 SD		
10/11	10/18	10/25	11/1
11/8	11/15	11/22	—
11/28	Run 12" 1400		
12/6	12" 1470 C.O.		
12/13	Dly 2055		
12/21	10" 2190 HFW 2205		
	2325 TD		
12/27	Dly 2455		
1/3/35	10" 2530		
1/10	Dly 2763		

(O O E R)

1935

1/17 Dlg 2819

1/24 " 3025

1/31 8" 2815 6" 3035

Chat 3048 S.O. 3065-77

Dlg 3150

2/7 5" 3375 Viola 3375

Wx 3406 T 3420

1500' fluid

2/14 3421 T 800' oil

Shot 5 gts S. 103 Bbls 8 hrs.

2/21 Shot 20 gts

2/28 —

3/6 Wilcox 3406

T 3421

266 oil

9 Water

COMPLETED

KANSAS

Map No. 43 Sec. 21 Twp. 21 R. 3W

Well No. 2-Neufeldt

Murphy et al Company

FIRST REPORTS Contractor

SECTION PLAT

 Ft. from N. Line

330 Ft. from S. Line

641 Ft. from E. Line

 Ft. from W. Line

Location

Rig up

Drilling and Remarks:

*Bedg.
Rot. Rig*

RECORD

Cased in., ft.

Sand

Gas

Oil

Total Depth

PRODUCTION

1st 24 hrs. Nat.

1st 24 hrs. after shot

Gas Cu. Ft.

Dry Hole

Abandoned

Date

6-6-34 19

ORVAL MANNSCHRECK

Scout

Map No. 43 Sec. 21 Twp. 21 R. 3W


Well No. 2-Neufelst

Murphy et al Company

Contractor

CORRECTION

SECTION PLAT

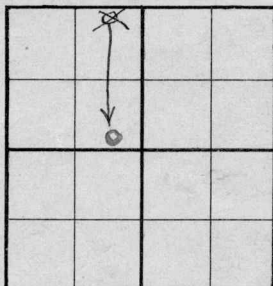

 Ft. from N. Line

330 Ft. from S. Line

641 Ft. from E. Line

 Ft. from W. Line

CORRECTION

Location

Rig up

Drilling and Remarks:

*Correct first
report to
correspond
with above
on*

RECORD

Cased in., ft.

Sand

Gas

Oil

Total Depth

PRODUCTION

1st 24 hrs. Nat.

1st 24 hrs. after shot

Gas Cu. Ft.

Dry Hole

Abandoned

Date

6-7-34 19

ORVAL MANNSCHRECK

Scout

Map No. 43 Sec. 21 Twp. 21 R. 3W

Well No. 2-Neufeldt

Murphy et al Company

Contractor

ABANDONED

SECTION PLAT

	0		

 Ft. from N. Line

330 Ft. from S. Line

640 Ft. from E. Line

 Ft. from W. Line

Location

Rig up

Drilling and Remarks:

Abd location

RECORD

Cased in., ft.

Sand

Gas

Oil

Total Depth

PRODUCTION

1st 24 hrs. Nat.

1st 24 hrs. after shot

Gas Cu. Ft.

Dry Hole

Abandoned

Date

19

ORVAL MANNSCHRECK Scout

Map No. 43 Sec. 21 Twp. 21 R. 3WWell No. 2-McnefeldtMcKarr et al Company

FIRST REPORTS

Contractor

CORRECTION

Correct

Company
Name

SECTION PLAT

Ft. from N. Line From

Murphy et al

Ft. from S. Line To

McKarr et al

Ft. from E. Line et al

Ft. from W. Line

O. W. D. D

Location _____

RECORD

Cased _____ in., _____ ft.

Sand _____

Gas _____

Oil _____

Total Depth _____

PRODUCTION

1st 24 hrs. Nat. _____

1st 24 hrs. after shot _____

Gas _____ Cu. Ft.

Dry Hole _____

Abandoned _____

Drilling and Remarks:

This is the old
Murphy et al
#2-Mcnefeldt
that was abandoned
last week.

DLG 3305

Date

9-19-37 19

ORVAL MANNSCHRECK

Scout

Map No. 43 Sec. 21 Twp. 21 R. 3W

Well No. 2-Neufeldt

Mc Knabb Company

Contractor

COMPLETED

SECTION PLAT

	0		

Ft. from N. Line

330 Ft. from S. Line

641 Ft. from E. Line

Ft. from W. Line

Location

Rig up

Drilling and Remarks:

*266 oil
9 water*

RECORD

Cased in, ft.

Sand *Wilcox* 3406

Gas

Oil

Total Depth 3421

PRODUCTION

1st 24 hrs. Nat.

1st 24 hrs. after shot

Gas Cu. Ft.

Dry Hole

Abandoned

Date

3-6-35 192

ORVAL MANNSCHRECK

Scout