

Mc Pherson


KANSAS

Form 51-5M-11-31-Palace

Map No. Sec. 19 Twp. 18 R. 2W

Well No. 1 Nordling Farm
Tom Palmer Company

NORTH

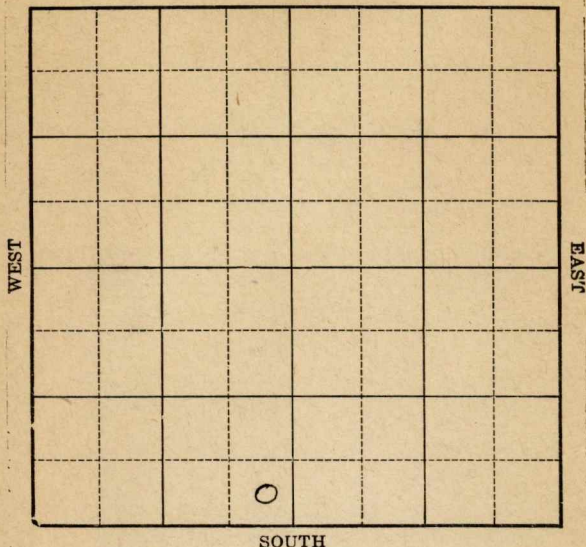

Location

Drilling Remarks

Rig Up

Drilling Remarks

RECORD

Cased in. ft.

Sand

Gas

Oil

Total Depth

PRODUCTION

1st 24 hrs. Nat.

1st 24 hrs. after shot

Gas cu. ft.

Dry Hole

Abandoned

Mc Pherson

Map No. KANSAS Sec. 19 Twp 18 R. 2W


Well No. 1 Noordling Farm
Tom Palmer Company

 Ft. from N. Line

330 Ft. from S. Line

330 Ft. from E. Line

 Ft. from W. Line

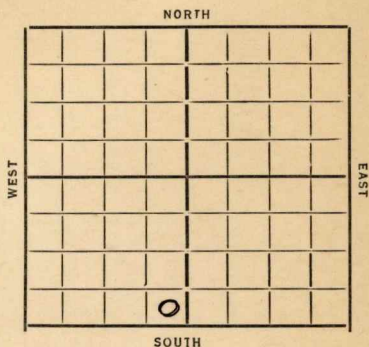

Date 1934

REPORT

OWDD

3/7 Location
3/15 Rig
3/22 B. R.
3/29 —
4/5 Spudded.
4/12 Dlg 1030
4/19 " 1490
4/26 " 1985 10" 1972
5/3 2150 HFW UR 10"
5/10 S.O. 2282 10" 2317 Dlg 2395
5/18 247W 2425 8 1/2 2586 Dlg 2630
5/25 Top chat 2858
8" 2832 U.R. 8"
5/31 6" 3192 TD 3197 ~~2000~~ oil PBP
6/6 Viola 3190 TD 3199
1000 acid 279 Bbls.

COMPLETED

1934

OWDD

6/13 OTD 3199 6" 3213
6/21 Hilcox 3279 HFW 3301
5" 3326 H. Viola 3246

- OVER -

6/28 5" 3368 Dlg 3397

7/5 Siliceous 3305 TD 3426
2474 PB KC Lime 2310

7/12 Testing

7/18 Dlg to top Siliceous
TD 3305 PB to K.C.L. 2310
1000 acid 339 Bbls oil

COMPLETED

Map No. 42 Sec. 19 Twp. 18 R. 2W

Well No. 1 - Nordling

Tom Palmer Company

Contractor

FIRST REPORTS

SECTION PLAT

.....Ft. from N. Line

330 Ft. from S. Line

330 Ft. from E. Line

.....Ft. from W. Line

Location ✓

Rig up

Drilling and Remarks:

RECORD

Cased.....in.,ft.

Sand

Gas

Oil

Total Depth

PRODUCTION

1st 24 hrs. Nat.

1st 24 hrs. after shot

Gas.....Cu. Ft.

Dry Hole

Abandoned

Date

3-7-34 192 O. Mannschied Scout

Map No. 42 Sec. 19 Twp. 18 R. 2WWell No. 1-WardlingTom Palmer Company

Contractor

COMPLETE**SECTION PLAT**

_____ Ft. from N. Line

330 Ft. from S. Line330 Ft. from E. Line

_____ Ft. from W. Line

Location _____

Rig up _____

Drilling and Remarks:

1000 acid279 bbls**RECORD**

Cased _____ in., _____ ft.

Sand Viola 3190

Gas _____

Oil _____

Total Depth 3199**PRODUCTION**

1st 24 hrs. Nat. _____

1st 24 hrs. after shot _____

Gas _____ Cu. Ft.

Dry Hole _____

Abandoned _____

Date

6-6-34

19

ORVAL MANNSCHRECK

Scout

Map No. 42 Sec. 19 Twp. 18 R. 2WWell No. 1- NordingTompalmer Company

Contractor

FIRST REPORT

SECTION PLAT

Ft. from N. Line

330 Ft. from S. Line330 Ft. from E. Line

Ft. from W. Line

Location _____

Rig up _____

Drilling and Remarks:

OTD 31996" 3213

RECORD

Cased _____ in., _____ ft.

Sand _____

Gas _____

Oil _____

Total Depth _____

PRODUCTION

1st 24 hrs. Nat. _____

1st 24 hrs. after shot _____

Gas _____ Cu. Ft.

Dry Hole _____

Abandoned _____

Date

6-13-37 19

ORVAL MANNSCHRECK

Scout

KANSAS

Map No. 42 Sec. 19 Twp. 18 R. 2WWell No. 1- WardlingTom Palmer Company

Contractor

COMPLETED

SECTION PLAT

 Ft. from N. Line330 Ft. from S. Line330 Ft. from E. Line Ft. from W. LineQwpdLocation Rig up

Drilling and Remarks:

Relg to top silurian
plug back to
K.e.L. 2310
1000 and
339 bbls
oil

RECORD

Cased in., ft.Sand Gas Oil Total Depth 3305

PRODUCTION

1st 24 hrs. Nat. 1st 24 hrs. after shot Gas Cu. Ft.Dry Hole Abandoned

Date

7-18-34 19

ORVAL MANNSCHRECK

Scout