

KANSAS


Form 51—5M—7-39—Palace

McPherson

Section 19 Township 18 Range 2-W

Well No. #1 Nordling

Company Barnett Drly. et al
~~F. S. Williams & Joe Morine~~

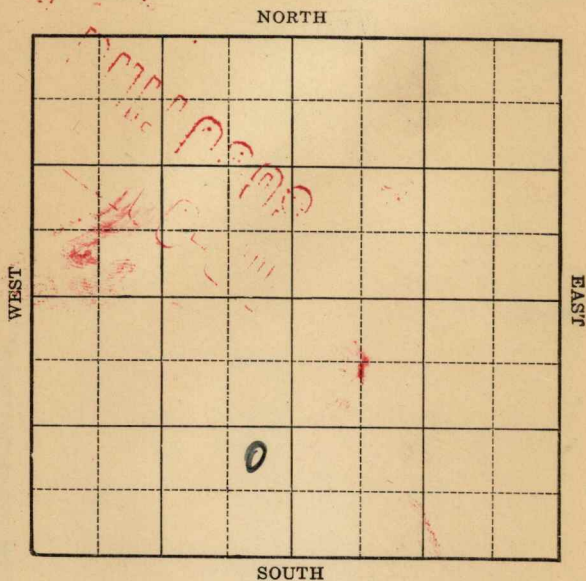

KANSAS


McPherson

Sec. 19 Twp. 18 R. 2-W ✓Well No. #1 Nordling Farm
Barnett Drilling, et al.
F. S. Williams & Joe Morine Company

(Misc.)

 Ft. from N. Line990 Ft. from S. Line330 Ft. from E. Line Ft. from W. Line

Elev. 1548

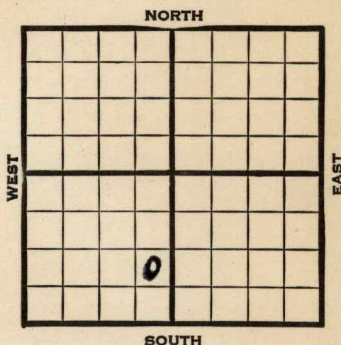

1940	Elev 1546'	REPORT
5/8		Move in cable tools.
5/16		Rigging up.
5/23	" "	
5/29	" "	
6/6	15" - 190'	Drlg. 260'
6/13	12" - 450'	Drlg. 845'
6/20		Drlg. 1455'
6/27	10" - 1492'	Drlg. 1829'
7/3	10" - 1836'	Drlg. 2147'
7/11	6" & K.C. 2286'	Oil 2297-2306'
	T.D. 2322'	
7/18	Pay 2322-28'	T.D. 2330'
		Pump 12 bbls. per day.
7/24	K.C. 2286'	
	6" - 2286'	
	T.D. 2330'	
	2000 acid.	
	Pump 25 bbls. ,	
COMPLETED		
(OLD PRODUCING WELL PLUGGED)		

(OLD PRODUCING WELL PLUGGED)

1949

4/27

RUR

5/4

8"@ 151'

D rlg 2630'

5/10

Lans 2286'

Miss 2836

Viola 3209'-14" WELL PLUG

T^D 3214'

5"@ 3209'

5/18

"

5/25

Swb 5 bbls oil PH

6/1

TD 3214'

Viola 3207'

5"@ 3209'

Pump 120 Pot

39° Gr.

Comp

COMPLETED

Map No. 42 Sec. 19 Twp. 18 R. 2WWell No. 1 Nordling

Joe Morine

F. S. Williams &

Company

Contractor

FIRST REPORT

NE SE SW

_____ Ft. from N. Line

990 Ft. from S. Line330 Ft. from E. Line

_____ Ft. from W. Line

MISCELLANEOUS

SECTION PLAT

Location _____

Rig up _____

Drilling and Remarks:

Move in Cable
Tools

RECORD

Cased _____ in., _____ ft.

Sand _____

Gas _____

Oil _____

Total Depth _____

PRODUCTION

1st 24 hrs. Nat. _____

1st 24 hrs. after shot _____

Gas _____ Cu. Ft.

Dry Hole _____

Abandoned _____

Date

MAY 8 1940

19

S. J. LEWIS

Scout

Map No. 42 Sec. 19 Twp. 18 R. 2WWell No. 1 NordlingF.S. Williams & Joe Morine Company

Contractor

COMPLETED

NE SE SW

 Ft. from N. Line990 Ft. from S. Line330 Ft. from E. Line Ft. from W. Line**SECTION PLAT**

	0		

MISCELLANEOUSLocation Rig up

Drilling and Remarks:

*HC 2286**6" @ 2286**2000 acid**Pump 25 P.S.***RECORD**Cased in., ft.Sand Gas Oil Total Depth 2330**PRODUCTION**1st 24 hrs. Nat. 1st 24 hrs. after shot Gas Cu. Ft.Dry Hole Abandoned

Date

JUL 24 1940 19S. J. LEWIS Scout

Kansas

Map No. _____ Sec. 19 Twp. 18 R. 2WWell No. 1 NordlingBarnett Drlg. etal. Company

FIRST REPORT

Contractor


NE SE SW

SECTION PLAT

_____ Ft. from N. Line

990 Ft. from S. Line330 Ft. from E. Line

_____ Ft. from W. Line

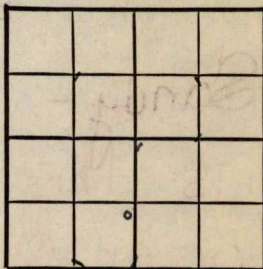McPherson County

Location _____

Rig up _____

Drilling and Remarks:

R U R

RECORD

Cased _____ in., _____ ft.

Sand _____

Gas _____

Oil _____

Total Depth _____

PRODUCTION

1st 24 hrs. Nat. _____

1st 24 hrs. after shot _____

Gas _____ Cu. Ft.

Dry Hole _____

Abandoned _____

Date

APR 27 1949 19S. J. LEWIS Scout

Sandy -

There was a well drilled
in this location in 7-1940

Is this an old well?

Advise Me —

Eddie O'Donnell,

Sandy -

Is this a New well
or an old one?

Advise -

Eddie -

Scout Cards	✓
Land Small Map	✓
Land Wall Map	✓
Tracings	✓
France Map	✓
Pierce Map	✓
Misc.	

Eddie

Kansas

Map No. _____ Sec. 19 Twp. 18 R. 2WWell No. 1 Nordling

Barnett Drlg. etal.

Company

CORRECTION

Contractor

NE SE SW

SECTION PLAT

_____ Ft. from N. Line

800 Ft. from S. Line330 Ft. from E. Line

_____ Ft. from W. Line

McPherson County

RECORD

Location _____

Cased _____ in., _____ ft.

Rig up _____

Sand _____

Drilling and Remarks:

Gas _____

Oil _____

Total Depth _____

Reported

990' from S line

all wells plugged

PRODUCTION

1st 24 hrs. Nat. _____

1st 24 hrs. after shot _____

Gas _____ Cu. Ft.

Dry Hole _____

Abandoned _____

Date

MAY 11 1949 19

S. J. LEWIS

Scout

Kansas

Map No. K 42 Sec. 19 Twp. 18 R. 2WWell No. 1 NordlingBarnett Drlg. etal. Company

COMPLETE

Contractor

NE SE SW

E 1, 1546.
SECTION PLAT

	0		

 Ft. from N. Line800 Ft. from S. Line330 Ft. from E. Line Ft. from W. Line

McPherson County

Location Rig up

Drilling and Remarks:

Victor 32075" C 3209Pump 120 Bt39-2-2

RECORD

Cased in., ft.Sand Gas Oil Total Depth 3214

PRODUCTION

1st 24 hrs. Nat. 1st 24 hrs. after shot Gas Cu. Ft.Dry Hole Abandoned

Date

JUN 1 1949 19S. J. LEWIS

Scout