

McPherson

KANSAS

SECTION 21 TOWNSHIP 21S RANGE 3W

WELL NO. #2 Neufeldt


COMPANY Brunson Prod.

NORTH

S/2 NE SW

WEST

EAST

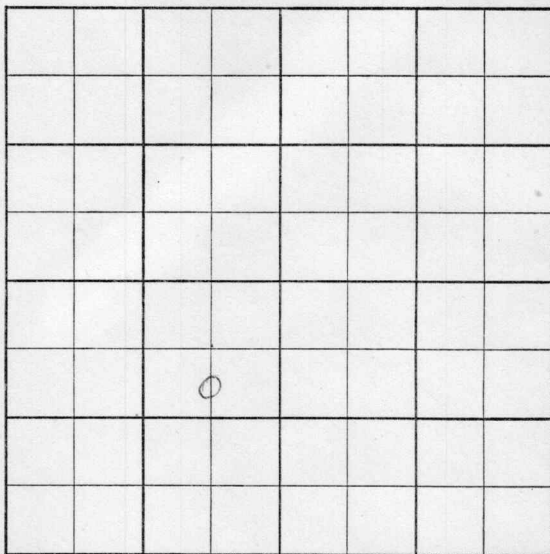

SOUTH

Twp. ~~21~~ Pool ~~21~~
Co. ~~21~~ Facet ~~21~~

S-513-B

County McPherson Elev. _____
Sec. 21 Twp. 21 Rge. 3W
Company Brunson Prod.
Farm Name Neufeldt No. 2

TOPS	DEPTH	LOG	DATUM
Anh.			
Tp.			
H.			
Tr.			
Dg.			
B.L.			
L.			
K.C.			
B.K.C.			
Ce.			
C.			
M.			
M.			
K.			
Mz.			
Mq.			
V.			
S.			
S.			
A.			
R.			
Pf.			
G.			
T.D.			

Loc. in Sec. S/2 NE SW
Geol. _____
Contr. _____
Co. Tools _____
Pool _____
Voshell



Date Comm. 6-10-58
8" @ 215, Drlg. 3116

Co.
Lse.
No.
Sec.
T.
R.

Twp. ✓ Pool ✓
 Co. ✓ Facet ✓

S-513.B

County McPherson Elev. 1464 DF 1467 RB
 Sec. 21 Twp. 21 Rge. 3W
 Company Brunson Prod.
 Farm Name Neufeldt No. 2

TOPS	DEPTH	LOG	DATUM
Anh.			
Tp.			
H.			
Tr.			
Dg.			
B.L.			
L.	<u>2148</u>		
K.C.			
B.K.C.			
Ce.			
C.			
M. <u>Chat</u>	<u>3052</u>		
M. <u>Li</u>	<u>3099</u>		
K.	<u>3127</u>		
Mz.	<u>3290</u>		
Mq. <u>do/o</u>	<u>3307</u>		
V. <u>3208</u>			
S.			
S.			
A.			
R.			
Pf.			
G.			
T.D.	<u>3327</u>		

Loc. in Sec. S/2 NE SW

Geol. _____
 Contr. _____
 Co. Tools _____

Pool _____
Voshell

COMPLETE
AUG 6 '58

Date Comm. 6-10-58

8" @ 215, Drlg. 3116 JUN 25 '58 DST 3060-80

1hr 60' OCM 60' V40 + gcm BHP

360 5" 3309 JUL 2 '58 ~ JUL 9 '58 JUL 16 '58

JUL 23 '58 JUL 30 '58 AUG 6 '58 Co 3327 1090

12hrs NW Proc 5x5 \$ 7 1/2 BO

+ 10BW 3hrs pop

P22 BOP + 490 W

MQ Do/o 3309 - 27"