


KANSAS

Section 32 Township 20S Range 14W

Well No. #1 Potts

Company Ferrell Drlg Co.

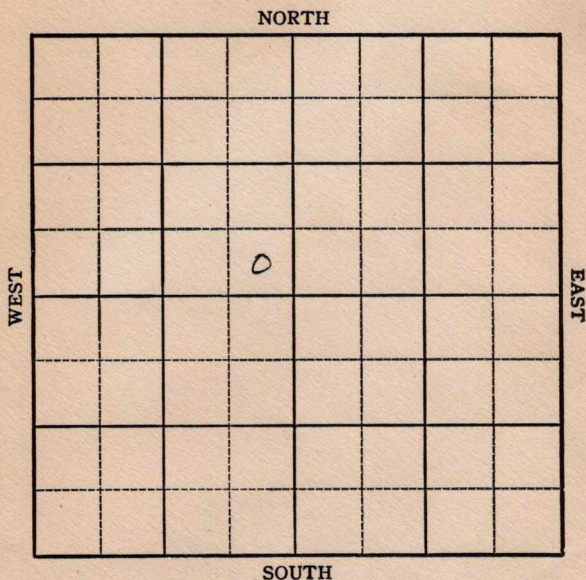

KANSAS

Barton

Sec. 32 Twp. 20 R. 14W ✓

Well No. #1 Unruh Potts Farm

H. E. Alexander Ferrell Oil Company

Unruh Wildcat


 Ft. from N. Line

330' Ft. from S. Line

330' Ft. from E. Line

 Ft. from W. Line

SE NW

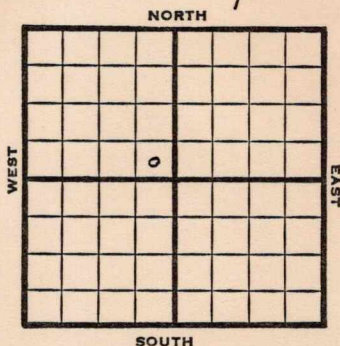

1949

Elev 192 1' REPORT

2/9 Location

2/16 8" @ 872'
Drlg. 2060'

2/23 **Lansing 3335'**
Simpson 3616'
Drlg 3620'

3/2 TD 3713'
Arb. 3650'
Aband.

ABANDONED

Map No. 82 Sec. 32 Twp. 20 R. 14WWell No. 1 PottsFerrell Drlg.

Company

ABANDONED

Contractor

SE NW

SECTION PLAT

Ft. from N. Line

330


Ft. from S. Line

330

Ft. from E. Line

Ft. from W. Line

Barton County

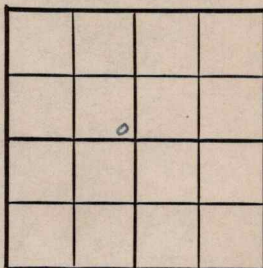

Location

Rig up

Drilling and Remarks:

CR 73650

RECORD

Cased _____ in., _____ ft.

Sand _____

Gas _____

Oil _____

Total Depth 2713

PRODUCTION

1st 24 hrs. Nat. _____

1st 24 hrs. after shot _____

Gas _____ Cu. Ft.

Dry Hole _____

Abandoned _____

Date

MAR 2 1949

19

S. J. LEWIS

Scout

Kansas

Unruh

Map No. _____ Sec. 32 Twp. 20 R. 14 WWell No. 1 UnruhH. E. Alexander Company

FIRST REPORT

Contractor

SE NW

SECTION PLAT

_____ Ft. from N. Line

330 Ft. from S. Line330 Ft. from E. Line

_____ Ft. from W. Line

BartonLocation ✓

Rig up _____

Drilling and Remarks:

RECORD

Cased _____ in., _____ ft.

Sand _____

Gas _____

Oil _____

Total Depth _____

PRODUCTION

1st 24 hrs. Nat. _____

1st 24 hrs. after shot _____

Gas _____ Cu. Ft.

Dry Hole _____

Abandoned _____

Date

FEB 9 1949 19

S. J. LEWIS Scout

Kansas

Map No. _____ Sec. 32 Twp. 20 R. 14WWell No. 1 Potts

Ferrell Drlg.

Company

CORRECTION

Contractor


SE NW

SECTION PLAT

_____ Ft. from N. Line

330 Ft. from S. Line330 Ft. from E. Line

_____ Ft. from W. Line

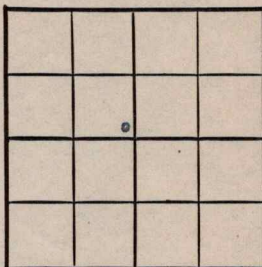

Barton County

Location _____

Rig up _____

Drilling and Remarks:

Reported as

H. E. Alexander

#1 Unruh

RECORD

Cased _____ in., _____ ft.

Sand _____

Gas _____

Oil _____

Total Depth _____

PRODUCTION

1st 24 hrs. Nat. _____

1st 24 hrs. after shot _____

Gas _____ Cu. Ft.

Dry Hole _____

Abandoned _____

Date

FEB 16 1949 19

S. J. LEWIS

Scout