


McPherson

Form 51-5M-11-31-Palace

Map No. KANSAS Sec. 21 Twp. 21 R. 3w

Well No. 2 - Newfield Farm
Derby Oil Company

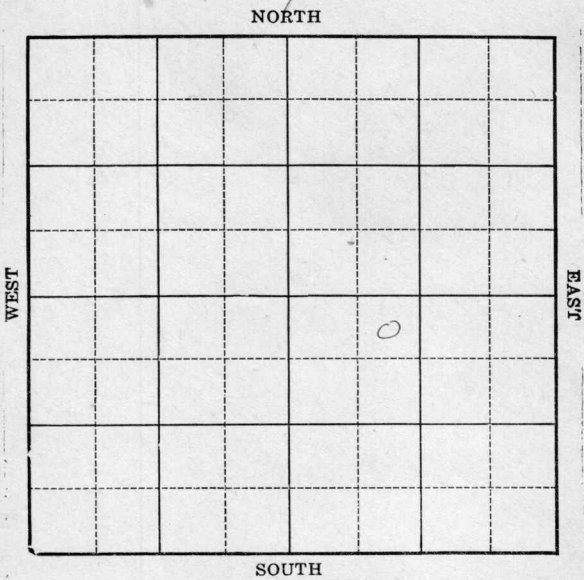

Location _____
Drilling Remarks _____

Rig Up _____
Drilling Remarks _____

RECORD

Cased _____ in. _____ ft.
Sand _____
Gas _____
Oil _____
Total Depth _____


PRODUCTION

1st 24 hrs. Nat. _____
1st 24 hrs. after shot _____
Gas _____ cu. ft.
Dry Hole _____
Abandoned _____

Map No. KANSAS Sec. 21 Twp. 21 R. 3^w

Well No. 2-New feed Farm
Derby Oil Company

NORTH

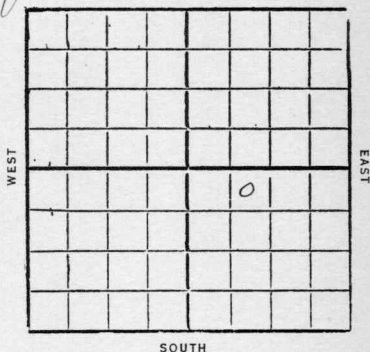

330 Ft. from N. Line

_____ Ft. from S. Line

_____ Ft. from E. Line

990 Ft. from W. Line

1932

Date

REPORT

9/14 *Cur*
9/21 *12"-168*
Dreg 1245
9/30 *" 2805*
10/5 *Top chat 3078*
Pem 8"-3080 517
10/12 *1 bailer water 3108-16*
Gay 3121-34
TD 3134
flow 267 bbl 3 hrs
" 145 " 4 "
and went dead
10/19 *Gay 3121-34*
TD 3134
Made 85 bbl oil and
100 bbls water
Comp

McPherson
 43 KANSAS Map No. _____ Sec. *21* Twp. *21* R. *3* ^W

Well No. *2 Newfelat* _____

Derby Oil Co _____

Company

Contractor

FIRST REPORTS

SECTION PLAT

		o	

330 Ft. from N. Line

_____ Ft. from S. Line

_____ Ft. from E. Line

990 Ft. from W. Line

Location _____

Rig up _____

Drilling and Remarks:

Rigging Rotary

RECORD

Cased _____ in., _____ ft.

Sand _____

Gas _____

Oil _____

Total Depth _____

PRODUCTION

1st 24 hrs. Nat. _____

1st 24 hrs. after shot _____

Gas _____ Cu. Ft.

Dry Hole _____

Abandoned _____

Date

SEP 14 1932

192

CHAS. L. SHERWOOD

Scout

Mepherson

43 KANSAS Map No. Sec. 21 Twp. 21 R. 3W

Well No. 2 Menfeldt

Herby Oil Co Company

Contractor

COMPLETED

OCT 19 1932

SECTION PLAT

330 Ft. from N. Line

Ft. from S. Line

Ft. from E. Line

990 Ft. from W. Line

Location

Rig up

Drilling and Remarks:

Pay 3121-34

85 B. oil +
100 B. water

RECORD

Cased in., ft.

Sand

Gas

Oil

Total Depth 3134

PRODUCTION

1st 24 hrs. Nat.

1st 24 hrs. after shot

Gas Cu. Ft.

Dry Hole

Abandoned

Date

Oct 19 1932

Sherwood Scout