


Section 17 Township 18 Range 2W

Well No. #2 Peterson

Company National Assoc.

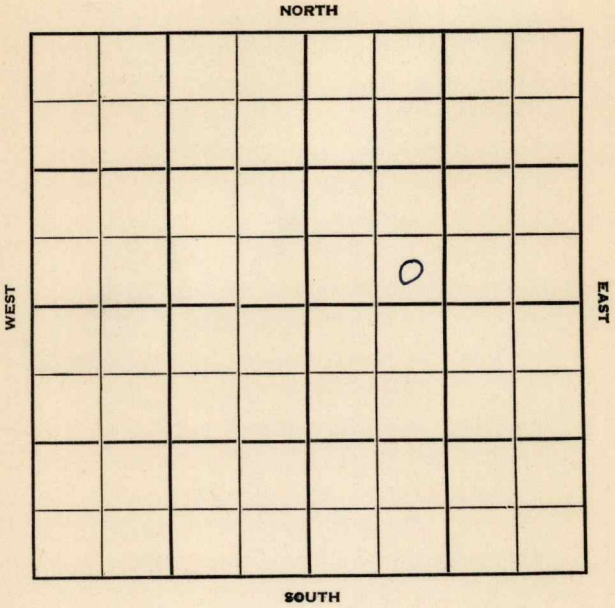

McPherson

KANSAS

Sec. 17 Twp. 18 R. 2W

Well No. #2 Peterson Farm _____

National Assoc. Company _____

Contractor _____


_____ Ft. from N. Line

330 Ft. from S. Line

_____ Ft. from E. Line

990 Ft. from W. Line

SE SW NE

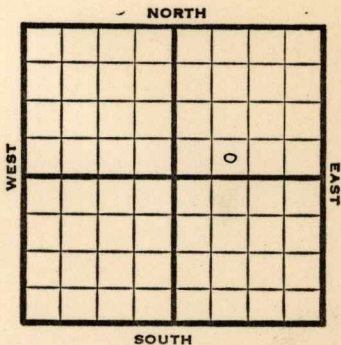

1951 **Elev. 1512'** REPORT

11/14
1952
1/23

Drlg.
Spud 11-18-51
Oil Well TD 3679
8" @ 218
Heeb. 2141 KC 2376
Kh 3311 Hunton 3449
Maq 3462 Viola 3599
Simp. 3668 TD 3674
5" @ 3668 CO to 3679
S/1 boph 2000 A
S/6 bfph Hydra P/6 bopd
PB 3675 S/3 bw 1 1/4 boph 4 hrs.
Comp. 10 bopd 60 bw

COMPLETED

County McPherson State Kansas

Sec. 17 (Blk. 18) (Sur. 2W) (Twp. 18) (Rge. 2W) Map No.

Operator National Assoc. Pet.

Well No. 2 Farm Peterson

Elev. 1512 Location SE SW NE

330 Ft. From S Line NE

990 Ft. From W Line Quarter

1st. Report

Completion JAN 23 1952

Remarks

Brack - Contr.

Spudding Date 11-18-51

Drlg. Data Oil well TD 3679

8" @ 218 Heeb. 2141 KC 2376

Kh. 3311 Hunton 3449 Maq. 3462

Viola 3599 Simp. 3668 TD 3674

5" @ 3668 CO to 3679 S/ 1 boph

2000 A S/ 6 bfph Hydro. P/ 6 bopd

PB 3675 S/ 3 bw 1 1/4 boph 4 hr.

Comp. 10 bopd 60 bw