


Section 33 Township 20 Range 14W

Well No. #3 McGreevy (A)

Company Tom Palmer

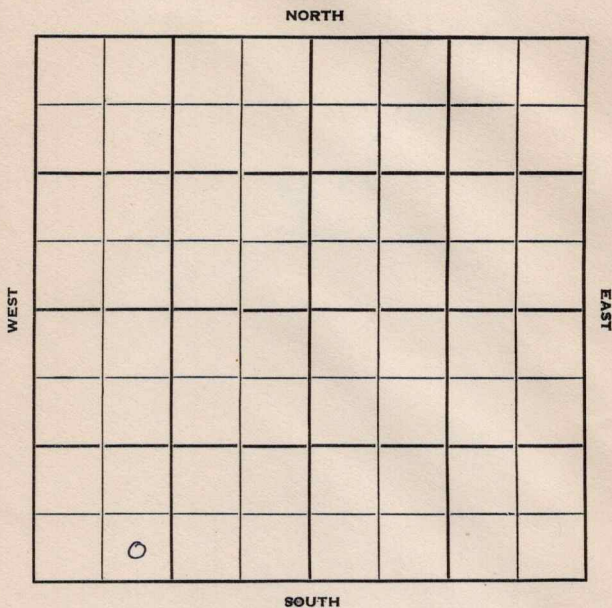

Barton

KANSAS

Sec. 33 Twp. 20 R. 14W ✓

Well No. #3 McGreevy (A) Farm

Tom Palmer Company

Tom Palmer Contractor

Bart-Staff

Ft. from N. Line

330


Ft. from S. Line

Ft. from E. Line

990

Ft. from W. Line

SE SW SW

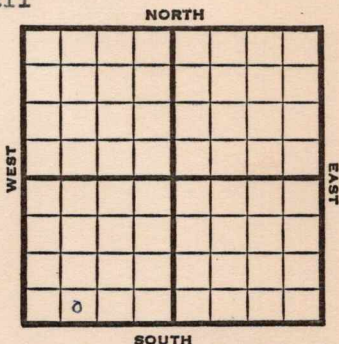

1951

Elev. 1915' REPORT

10/10 RUR

1952

2/6 TD 3580 5" @ 3578

2/13 No report

2/20 "

3/5 NR

3/11 "

3/19 Spud 10-9-51 Oil Well TD 3181

Anhy 829 8" @ 832 Heeb. 3178

Br Lime 3278 Lans. 3290

Arb. 3578 5" @ 3578

TD 3181 wtr SP 3571

23/3562-68 wtr 5/3444-48

No inc. 11/3375-85 FU 1200' sw

SP 3368 42/3352-64 FU 1400' oil

Comp. 99 bopd

COMPLETED

County **Barton** State **Kansas**

Sec. **33** (Blk. Twp.) **20** (Sur. Rge.) **14W** Map No.

Operator Tom Palmer

Well No. 3 Farm McGreevy (A)

Elev.	Location	SE	SW	SW
-------	----------	----	----	----

FIRST REPORT

330 Ft. From S Line SW

990 Ft. From W Line Quarter

1st. Report **OCT 10 1951**

Completion

Remarks

Tom Palmer - Contr.

Spudding Date _____

Drig. Data Bart-Staff

RUR

County Barton State KansasSec. 33 (Blk.
Twp.) 20 (Sur.
Rge.) 14W Map No.Operator Tom PalmerWell No. 3 Farm McGreedy "A"Elev. 1915 Location SE SW SW

330 Ft. From S Line SW990 Ft. From W Line Quarter

1st. Report

Completion MAR 19 1952Remarks Bart-Staff PoolTom Palmer - Contr.Spudding Date 10-9-51Drlg. Data Oil well TD 3181Anhy 829 8" @ 832 Heeb. 3178Br. lime 3278 Lans. 3290 Arb. 35785" @ 3578 TD 3181 water SP 357123/ 3562-68 water 5/ 3444-48no inc. 11/ 3375-85 FU 1200' swSP 3368 42/ 3352-64 FU 1400' oilComp. 99 bopd

J. G. McGEHEE