

Form 51—5M—11-31—Palace

Map No. 2 Sec. 2

Sec.

Twp.


R.

Well No.

Farm

Company

NORTH

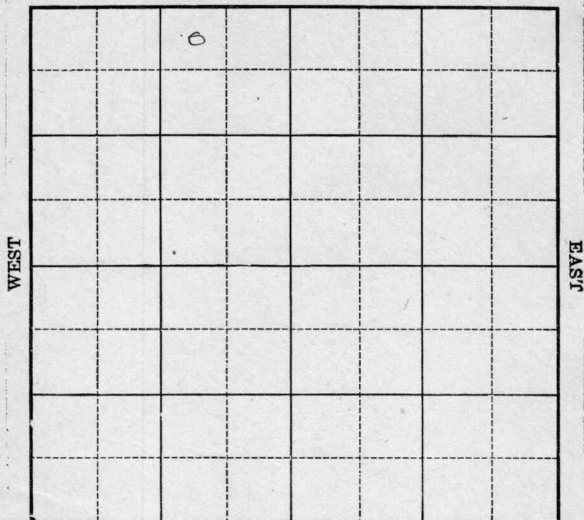

Location

Drilling Remarks

Rig Up

Drilling Remarks

RECORD

Cased _____ in. _____ ft.

Sand

Gas

Oil

Total Depth _____

PRODUCTION

1st 24 hrs. Nat.-----

1st 24 hrs. after shot-----

Gas _____ cu. ft.

Dry Hole_____


Abandoned.....

Map No. KANSAS Sec. 28 Twp. 21 R. 3^w

Well No. 2- Newfield Farm

W.C. Mc Bride, Inc. Company

NORTH

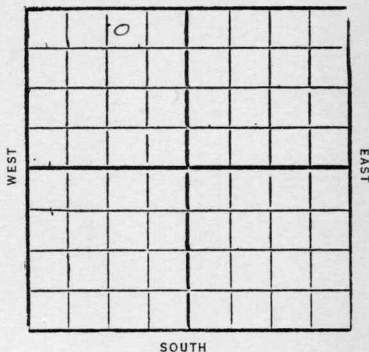

330 Ft. from N. Line

_____ Ft. from S. Line

_____ Ft. from E. Line

1716 Ft. from W. Line

1932

Date

REPORT

9/21	Pos.
9/30	Aug.
10/5	dreg 400'
10/12	15"-516
	Dreg 1255
10/19	" 1920'
10/26	13"-1632
	Dreg 2310'
11/2	10"-2310'
	TD 2412 UIR 10"
11/9	10"-2417
	dreg 2428'
11/16	" 2625'
11/23	Aug 8"-2768'
11/30	8"-2840
	TD 2895 UIR 8"
12/7	Top Chat 3044
	Show gas 3046
	setg 8"-3046'
12/14	TD 3050 fishing
12/21	

(over)

12/28 dreg 3078" in chat
1 1/4 ft gas & show oil

1933

1/4 Base lime 3152

6"-3308

Viola ~~3428-30~~ 3424
show gas

VIR 6"

1/11 Base Viola 3448

Welcox 3450

Sand & green shale to 3462
show oil & water 3460

SD 3462 1/2'

1/18- TD 3481

PB. to 3070

1/25 Viola 3428-48

Welcox 3450-81

TD 3481

show oil & water

PB. to 3080

shot 20 qt 3070-76

Pump 8 bbl 24 hr

Comp

McPherson *W*
 43 KANSAS Map No. Sec. 28 Twp. 21 R. 3

Well No. 2 *Neufeld*
N. C. McBride, Inc. Company

Contractor

FIRST REPORTS

330 Ft. from N. Line

Ft. from S. Line

Ft. from E. Line

1716 Ft. from W. Line

SECTION PLAT

	0		

Location

Rig up

Drilling and Remarks:

Pro y

RECORD

Cased in., ft.

Sand

Gas

Oil

Total Depth

PRODUCTION

1st 24 hrs. Nat.

1st 24 hrs. after shot

Gas Cu. Ft.

Dry Hole

Abandoned

Date

SEP 21 1932

192

CHAS. L. SHERWOOD

Scout

McPherson

43 KANSAS

Map No. Sec. 28 Twp. 21 R. 3

Well No. 2 New Jewel

N.C. Mc Bride, Inc. Company

Contractor

COMPLETED

SECTION PLAT

	0		

330 Ft. from N. Line

Ft. from S. Line

Ft. from E. Line

1716 Ft. from W. Line

Location

Rig up

Drilling and Remarks:

Viola 3428-48

Wilcox 3450-81-

50 ft Water. P.B. to

3080 - Shot 20/3070

Pump 8 Bbls
24 Hours.

RECORD

Cased in., ft.

Sand

Gas

Oil

Total Depth 3481

PRODUCTION

1st 24 hrs. Nat.

1st 24 hrs. after shot

Gas Cu. Ft.

Dry Hole

Abandoned

Date

JAN 25 1933

192

CHAS. L. SHERWOOD

Scout