


Section 33 Township 20 Range 14W

Well No. #1 McGreevey "B"

Company Palmer Oil

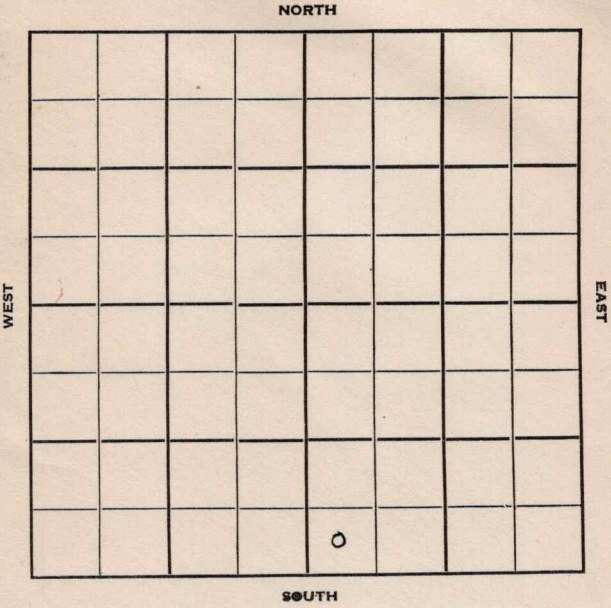

Barton

Sec. 33 Twp. 20 R. 14 W

Well No. # 1 McGreevey "B" Farm

Palmer Oil Company

Contractor


Ft. from N. Line

330 Ft. from S. Line

Ft. from E. Line

330 Ft. from W. Line

SW SW SE

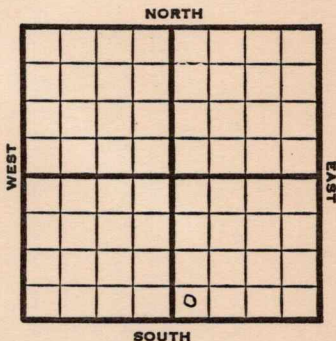

1951

Elev. 1913'

REPORT

5/2

Location

6/20

Spud 5-8-51

Oil well TD 3566' 8" @ 831

Lans. 3292'

DST 3294-3328' open $\frac{1}{2}$ hr. rec 65' O & GCM

DST 3410-54 open $\frac{1}{2}$ hr. rec 180' HOCM 30' oil

Arb. 3560-66' 5" @ 3561 1500 A

Comp. deptho pot. 2156 BOPD 5% water

COMPLETED

