

Form 51—5M—11-31—Palace

Map No. _____ Sec. 33 Twp. 21 R. 3W

Well No. 3 - Friesen Farm

Mabee-Shell Company

NORTH

WEST

EAST

SOUTH

Location

Drilling Remarks

Rig Up

Drilling Remarks

RECORD

Cased _____ in. _____ ft.

Sand

Gas

Oil

Total Depth.....

PRODUCTION

1st 24 hrs. Nat. _____

1st 24 hrs. after shot_____

Gas _____ cu. ft.

Dry Hole

Abandoned

McPherson

Form 252-A
5M 4-32 MPC

Map No. KANSAS Sec. 33 Twp. 21 R. 3W


Well No. #3 Friesen Farm
Mabee + Shell Company

 Ft. from N. Line

330 Ft. from S. Line

 Ft. from E. Line

330 Ft. from W. Line

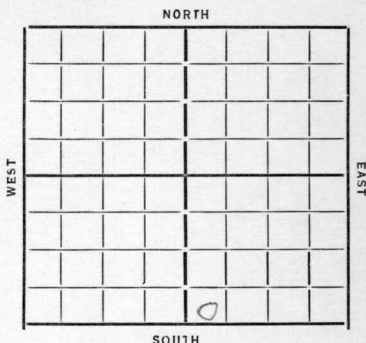

Date
1933

REPORT

9/13 location

9/20 9/29 R.O.C.

10/15 15" 301 T.D. 445-10,000

10/11 Drill 2035

10/18 Top chat 3159 - Drill 3278

10/25 Top. Hunter 3481 - T.D. 3486

6" at 3481 - R.M.S.T.

11/1 Drill 3492 - 1500' oil in hole

11/8 T.D. 3495 swab 55 bbls 4 hrs
treating with 1000 gal acid

11/15 —

11/22 Run 5" at 3483

11/29 —

12/6 Swab 120 bbls 11 hrs.

12/13 taking potential

12/20 Hunter 3481-95 T.D.

730 bbls

COMPLETED

Map No. 43 Sec. 33 Twp. 21 R. 3W

Well No. #3 - Trippen

Wabe & Shell Company

Contractor

SECTION PLAT

Ft. from N. Line

330 Ft. from S. Line

Ft. from E. Line

330 Ft. from W. Line

FIRST REPORTS

Location

Rig up

Drilling and Remarks:

RECORD

Cased in., ft.

Sand

Gas

Oil

Total Depth

PRODUCTION

1st 24 hrs. Nat.

1st 24 hrs. after shot

Gas Cu. Ft.

Dry Hole

Abandoned

Date

9/13/33 192 Scout

Map No. 43 Sec. 33 Twp. 21 R. 3W

Well No. 3 - Friesen

Mabee & Shell Company

Contractor

COMPLETED

SECTION PLAT

		0	

Ft. from N. Line

330 Ft. from S. Line

Ft. from E. Line

330 Ft. from W. Line

Location

Rig up

Drilling and Remarks:

730 bbls

RECORD

Cased in., ft.

Sand Hunter 3481

Gas

Oil

Total Depth 3495

PRODUCTION

1st 24 hrs. Nat.

1st 24 hrs. after shot

Gas Cu. Ft.

Dry Hole

Abandoned

Date

12-20-33 192 O. Mannschreck Scout