


Mr. P. Person

Form 51-5M-11-31-Palace

Map No. KANSAS Sec. 33 Twp. 21 R. 3 ^{*W*}

Well No. 5 Fressen Farm
Mabee & Shell Company

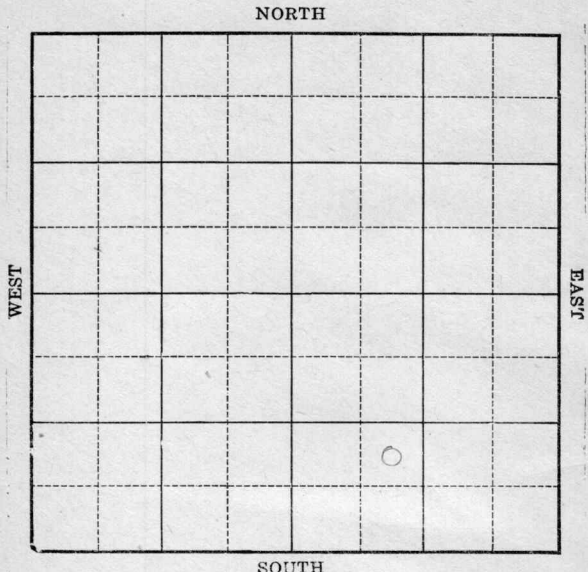

Location _____
Drilling Remarks _____

Rig Up _____
Drilling Remarks _____

RECORD

Cased _____ in. _____ ft.
Sand _____
Gas _____
Oil _____
Total Depth _____

PRODUCTION

1st 24 hrs. Nat. _____
1st 24 hrs. after shot _____
Gas _____ cu. ft.
Dry Hole _____
Abandoned _____

MC Pherson

Map No. Sec. 33 Twp. 21 R. 30

Well No. #5 Irwin Farm


Mabee & Shell Company

 Ft. from N. Line

990' Ft. from S. Line

 Ft. from E. Line

990' Ft. from W. Line

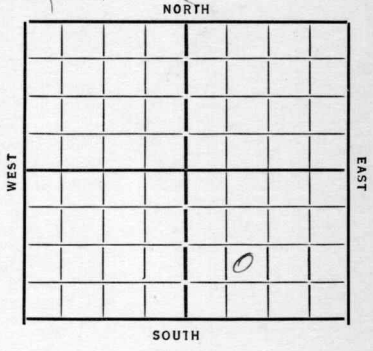

Date 1/33

REPORT

11/22 R.O. G.
11/29 Rig
12/6
12/13 15" - 315'
12/27 drlg 2408
1/4 chat 3221 - T.D. 3483 - run 7"
1/11 Hunton 3482 T.D. 3484 - RMST.
1/17 7" at 3482 - T.D. 3494
1500' oil in hole
1/24
1/31 Hunton 3482 TD 3484 1995 BBL

COMPLETED

Map No. 43 Sec. 33 Twp. 21 R. 3W

Well No. 5-Prisen

Mabe & Shell Company

Contractor

FIRST REPORTS

Ft. from N. Line

990 Ft. from S. Line

Ft. from E. Line

990 Ft. from W. Line

SECTION PLAT

Location

Rig up

Drilling and Remarks:

Material on ground

RECORD

Cased in., ft.

Sand

Gas

Oil

Total Depth

PRODUCTION

1st 24 hrs. Nat.

1st 24 hrs. after shot

Gas Cu. Ft.

Dry Hole

Abandoned

Date

11-22-33 192

O. Mannschuld Scout

Map No. *43* Sec. *33* Twp. *21* R. *3W*

Well No. *5-Friesen*

Mabe + Shell Company

Contractor

COMPLETED

SECTION PLAT

Ft. from N. Line

990 Ft. from S. Line

Ft. from E. Line

990 Ft. from W. Line

Location

Rig up

Drilling and Remarks:

RECORD

Cased in., ft.

Sand *Horton 3482*

Gas

Oil

Total Depth *3484*

PRODUCTION

1st 24 hrs. Nat.

1st 24 hrs. after shot

Gas Cu. Ft.

Dry Hole

Abandoned

Date

1-31-34 192 *O. Mannick* Scout

1975 bbb