

McPherson


KANSAS

Form 51-5M-11-31-Palace

Map No. _____ Sec. *28* Twp. *21* R. *3W*

Well No. *1-Schraeder* Farm _____

Gled + Shell Company _____

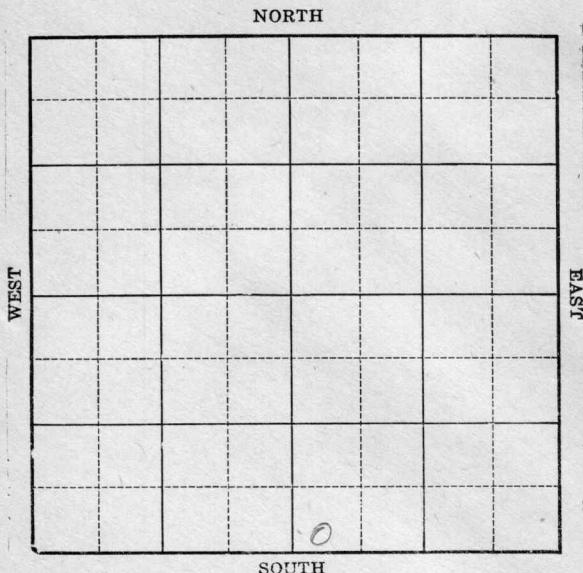

Location _____

Drilling Remarks _____

Rig Up _____

Drilling Remarks _____

RECORD

Cased _____ in. _____ ft.

Sand _____

Gas _____

Oil _____

Total Depth _____

PRODUCTION

1st 24 hrs. Nat. _____

1st 24 hrs. after shot _____

Gas _____ cu. ft.

Dry Hole _____

Abandoned _____

Map No. _____ Sec. 28 Twp. 21 R. 3W

Well No. 1-Schroeder Farm


Gled + Shell Company

_____ Ft. from N. Line

330 Ft. from S. Line

_____ Ft. from E. Line

330 Ft. from W. Line

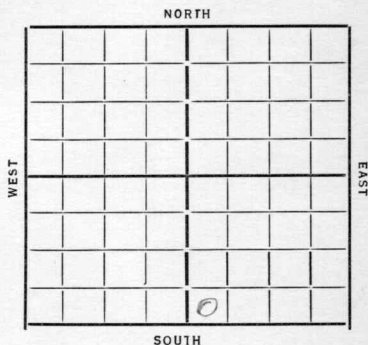

Date 1933

REPORT

7/26 Cellar
8/12 Moving material
8/19 13" - 209' W, O, L
8/17 dig 1725'
8/23 " 2800'
8/30 Top Chat 3105 B. Line 3298 Rumb " 3438
T.W. 3441
9/6 _____
9/15 D. + A 3580
T.W. 3572

ABANDONED

Map No. 43 Sec. 28 Twp. 21 R. 3W

Well No. 1- Schroeder

Eled + Shell Company

Contractor

SECTION PLAT

Ft. from N. Line

330 Ft. from S. Line

Ft. from E. Line

330 Ft. from W. Line

FIRST REPORT

Location

Rig up

Drilling and Remarks:

cellar

RECORD

Cased in., ft.

Sand

Gas

Oil

Total Depth

PRODUCTION

1st 24 hrs. Nat.

1st 24 hrs. after shot

Gas Cu. Ft.

Dry Hole

Abandoned

Date

7/26/33 192 O. Manschreck Scout

Map No. 43 Sec. 28 Twp. 21 R. 3W

Well No. 1 Schroeder

Steel & Shell Company

Contractor

SECTION PLAT

		0	

Ft. from N. Line

330 Ft. from S. Line

Ft. from E. Line

330 Ft. from W. Line

ABANDONED

Location

Rig up

Drilling and Remarks:

U + A

RECORD

Cased in., ft.

Sand Wilcox 3572

Gas

Oil

Total Depth 3580

PRODUCTION

1st 24 hrs. Nat.

1st 24 hrs. after shot

Gas Cu. Ft.

Dry Hole

Abandoned

Date

9/15/33 192 Oval Manuscript Scout