


McPherson


KANSAS

SECTION 35 TOWNSHIP 21S RANGE 3W

WELL NO. #2 Goering "B"

COMPANY Brunson Prod.

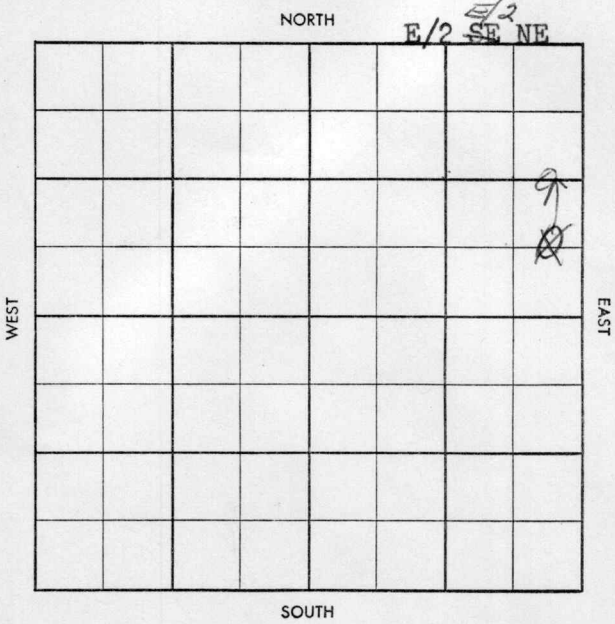

 

County McPherson Elev. _____
 Sec. 35 Twp. (21) Rge. 3W
 Company Brunson Prod.
 Farm Name Goering "B" No. 2

TOPS	DEPTH	LOG	DATUM
Anh.			
Tp.			
H.			
Tr.			
Dg.			
B.L.			
L.			
K.C.			
B.K.C.			
Ce.			
C.			
M.			
M.			
K.			
Mz.			
Mq.			
V.			
S.			
S.			
A.			
R.			
Pf.			
G.			
T.D.			

Loc. in Sec. _____


E/2 SE NE

Geol. _____

Contr. _____

Co. tools

Pool _____

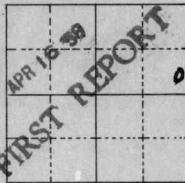HarmacDate Comm. 4-11-578" @ 200 drlg. 2627

Co.

Lse.

No.

Sec.

T.

R.

CORRECTION

Co.

Pool

Facet

H 0 49609

S-513-B

County McPherson Elev. 1461 KB 1458 DA
 Sec. 35 Twp. 21 Rge. 3W
 Company Brunson Prod.
 Farm Name Goering "B" No. 2

TOPS	DEPTH	LOG	DATUM	Loc. in Sec.
Anh.				<u>E/2 SE NE</u>
Tp.				<u>E/2 E/2 NE</u>
H.				
Tr.				
Dg.				
B.L.				
L.	<u>2426</u>			
K.C.				Geol. <u>Brooks</u>
B.K.C.				Contr.
Ce.				<u>Co. tools</u>
C. <u>Huntton</u>	<u>3127</u>			Pool
M.				<u>Harmac</u>
M.				
K.	<u>3426</u>			
Mz.	<u>3525</u>			
Mq. <u>Huntton</u>	<u>3527</u>			
V. <u>Mq Delo</u>	<u>3536</u>			
S.				
S.				
A.				
R.				
Pf.				
G.				
T.D.	<u>3545</u>			

COMPLETE

JUN 25 '58

Date Comm. 4-11-57

8" @ 200 drlg. 2627 APR 23 '58 Tops APR 30 '58

Tops No DST 5 1/2 3528

MAY 7 '58 CO

3545 TD 2500 A \$30 Boph NW

4hrs pop MAY 14 '58 MAY 21 '58 Pipe ok

MAY 28 '58 JUN 4 '58 JUN 11 '58 JUN 18 '58 JUN 25 '58

Pot P 247 Boph & NW q. 43°
Huntton