


Mc Pherson

Form 51-5M-5-34-Palace

Map No. KANSAS Sec. 33 Twp. 21 R. 3W

Well No. 8 Griesen Farm
Mabu & Shell Company

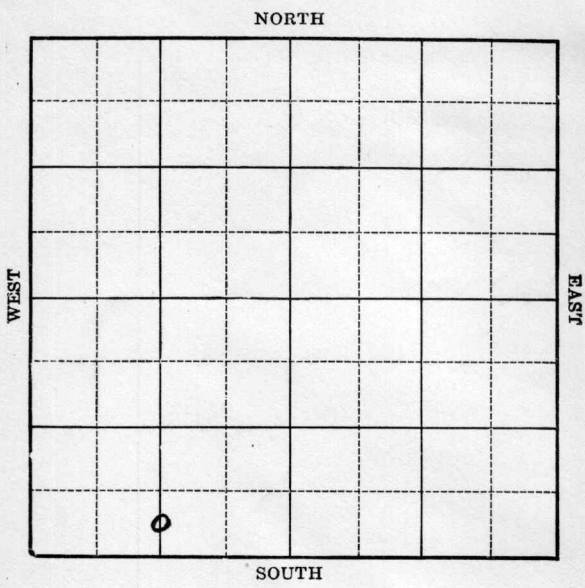

Location _____
Drilling Remarks _____

Rig Up _____
Drilling Remarks _____

RECORD

Cased _____ in. _____ ft.
Sand _____
Gas _____
Oil _____
Total Depth _____

PRODUCTION

1st 24 hrs. Nat. _____
1st 24 hrs. after shot _____
Gas _____ cu. ft. _____
Dry Hole _____
Abandoned _____

McPherson

Map No. KANSAS Sec. 33 Twp 21 R. 3W


Well No. 8 Friesen Farm
Maher & Shell Company

 Ft. from N. Line

330 Ft. from S. Line

 Ft. from E. Line

1335 Ft. from W. Line

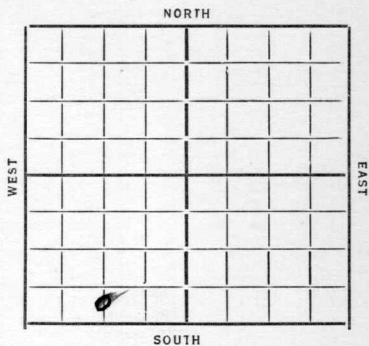

Date 1934

REPORT

7/11 Rot Rig
7/19 Dlg 150
7/26 " 1990
8/2 " 3100 KCL 2428
8/9 T Chat 3158 Miss L 3481
T Hutton 3482 7" 3482
T D 3492 Rust
8/16
8/22 Hutton 3482 T D 3492
1576 Bbls,

COMPLETED

Map No. 43 Sec. 33 Twp. 21 R. 3N

Well No. 8-Orviseu

Mahee & Shell Company

FIRST REPORTS

Contractor

C N L SW

SECTION PLAT

 Ft. from N. Line

330 Ft. from S. Line

 Ft. from E. Line

1325 Ft. from W. Line

Location

Rig up

Drilling and Remarks:

Lost Rig

RECORD

Cased in., ft.

Sand

Gas

Oil

Total Depth

PRODUCTION

1st 24 hrs. Nat.

1st 24 hrs. after shot

Gas Cu. Ft.

Dry Hole

Abandoned

Date

ORVAL MANNSCHRECK

7-11-34 19

Scout

KANSAS

Map No. 43 Sec. 33 Twp. 21 R. 3W

Well No. 8-Priesen

Mabee & Shell Company

COMPLETED Contractor

SECTION PLAT

 Ft. from N. Line

330 Ft. from S. Line

 Ft. from E. Line

1325 Ft. from W. Line

Location

Rig up

Drilling and Remarks:

1576 bbls

RECORD

Cased in., ft.

Sand Huntton 3482

Gas

Oil

Total Depth 3492

PRODUCTION

1st 24 hrs. Nat.

1st 24 hrs. after shot

Gas Cu. Ft.

Dry Hole

Abandoned

Date

8-22-31

ORVAL MANNSCHRECK

19

Scout