


Section 33 Township 21 Range 3W

Well No. 1 Hamm

Company M & L Oil

Holl-Nickel

NORTH

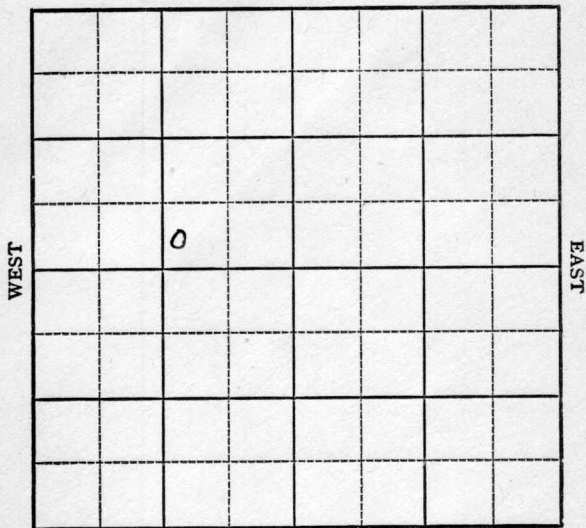

SOUTH

KANSAS

McPherson

Sec. 33 Twp. 21 R. 3W 

Well No. #1 Hamm Farm

M & L Oil

Company


Holl-Nickel

 Ft. from N. Line

330' Ft. from S. Line

1255' Ft. from E. Line

 Ft. from W. Line

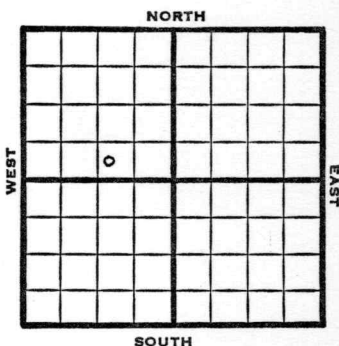

SW SE NW

1948

Eli 1463'

R E P O R T

10/27 Location
11/3 Drlg 2000'
11/10 8"@ 321'
Mississippi 3142'
11/16 Drlg. 3144'
11/23 Whipstock 2029'
11/30 Miss 3137'
Hunton 3452-56'
TD 3456'
5"@ 3453'
12/6 TD 3473'
Plug 3264'
5 shots 3149-54
SS Gas
12/15 TD 3473'
Hunton 3452'
Aband.
ABANDONED

Map No. _____ Sec. 33 Twp. 21 R. 3W

Well No. 1 Hamm

M & L Oil

Company

FIRST REPORT

Contractor

SW SE NW


SECTION PLAT

_____ Ft. from N. Line

330 Ft. from S. Line

1255 Ft. from E. Line

_____ Ft. from W. Line

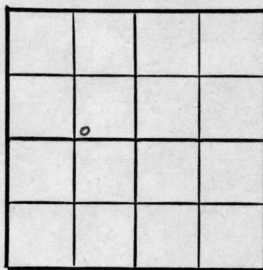

McPherson County

Location X

Rig up _____

Drilling and Remarks:

RECORD

Cased _____ in., _____ ft.

Sand _____

Gas _____

Oil _____

Total Depth _____

PRODUCTION

1st 24 hrs. Nat. _____

1st 24 hrs. after shot _____

Gas _____ Cu. Ft.

Dry Hole _____

Abandoned _____

Date

OCT 27 1948

19

S. J. LEWIS

Scout

Kansas

Holl-Nickel Pool

Map No. 43 Sec. 33 Twp. 21 R. 3WWell No. 1 HammM & L Oil Company**ABANDONED**

Contractor

SW SE NW

E. 1463
SECTION PLAT

	0		

 Ft. from N. Line330 Ft. from S. Line1255 Ft. from E. Line Ft. from W. LineMcPherson CountyLocation Rig up

Drilling and Remarks:

*Run to 3428***RECORD**Cased in., ft.Sand Gas Oil Total Depth 3428**PRODUCTION**1st 24 hrs. Nat. 1st 24 hrs. after shot Gas Cu. Ft.Dry Hole Abandoned

Date

DEC 15 194819S. J. LEWISScout