

WEST

EAST

SOUTH

Rig Up.....

Drilling Remarks

PRODUCTION

1st 24 hrs. Nat.....

1st 24 hrs. after shot.....

Gas.....cu. ft.....

Dry Hole.....

Abandoned.....

Map No. Sec. Twp. R.

Well No. Farm


..... Company

..... Ft. from N. Line

..... Ft. from S. Line

..... Ft. from E. Line

..... Ft. from W. Line

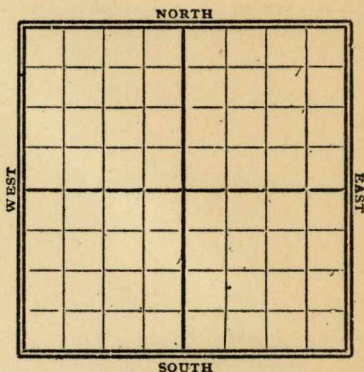

Date

REPORT

Gypsy Roads

*10/27 7 M gas
1008# R P
TD 2946*


MAP No. _____ SEC. 29 TWP. 18 S R. 2 W

WELL No. Anderson

E. B. Merriam COMPANY

CONTRACTOR

SECTION PLAT

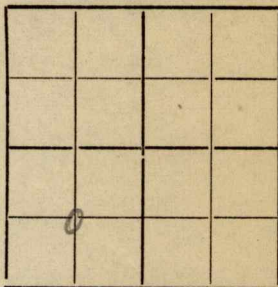

_____ FT. FROM N. LINE

_____ FT. FROM S. LINE

_____ FT. FROM E. LINE

_____ FT. FROM W. LINE

LOCATION _____

RIG UP _____

DRILLING AND REMARKS:

*1008th R. P.
on with
casing*

RECORD

CASED _____ IN. _____ FT.

SAND _____

GAS ☒

OIL _____

TOTAL DEPTH 2946

PRODUCTION

1ST 24 HRS. NAT. _____

1ST 24 HRS. AFTER SHOT _____

GAS 7 m CU. FT.

DRY HOLE _____

ABANDONED _____

DATE

10/29 1926 SCOUT