

Map No. KANSAS Sec. 33 Twp. 21 R. 3rd

Well No. 1 Splassen Farm

Wabe & Chell Company

WEST

EAST

SOUTH

Location _____
Drilling Remarks _____

Rig Up _____
Drilling Remarks

Cased _____ in. _____ ft.

Gas _____

Total Depth_____

1st 24 hrs. Nat.-----

Gas_____cu. ft._____

Dry Hole_____

Abandoned_____

Map No. KANSAS Sec. 33 Twp. 21 R. 3^w

Well No. 1-Klassen Farm
Mabee & Chell Company


NORTH

330 Ft. from N. Line

_____ Ft. from S. Line

_____ Ft. from E. Line

330 Ft. from W. Line

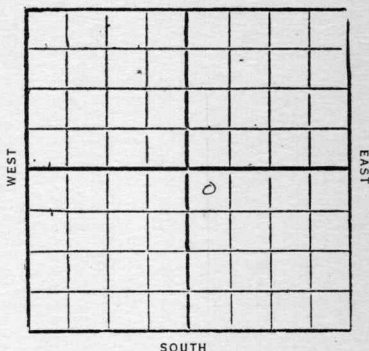

Date

REPORT

11/2	Log
11/9	Reg
11/16	15"-248
	dry 1030'
11/23	" 2865'
11/30	Top Chat 3132
	Base line 3322
	8"-3415 Rust
12/7	Top Huntow 3451-58
	flow 104 bbl per hr
	for 13 hrs
	shut in
12/14	TD 3458
	flow 1464 bbl 14 hr
	shut in
12/21	TD 3458
	flow 60 bbl per hour
12/28	Cased 8"-3415
	Huntow 3451-58
	TD 3458
	flow 1488 bbl 14 hr
	shut in - Comp.

43 KANSAS Sec. 33 Twp. 21 R. 3

Well No. 1 Klassen
Mabee & Sheel Company

Contractor

FIRST REPORTS

SECTION PLAT

330 Ft. from N. Line
Ft. from S. Line
Ft. from E. Line
330 Ft. from W. Line

		o	

Location ✓

Rig up

Drilling and Remarks:

RECORD

Cased in., ft.

Sand

Gas

Oil

Total Depth

PRODUCTION

1st 24 hrs. Nat.

1st 24 hrs. after shot

Gas Cu. Ft.

Dry Hole

Abandoned

Date

NOV 2 1932 CHAS. L. SHERWOOD
192 Scout

McPherson

43 KANSAS

Map No. _____ Sec. 33 Twp. 21 R. 3 W

Well No. 1 Klassen

Maber & Shell Company

Contractor

COMPLETED

SECTION PLAT

330 Ft. from N. Line

_____ Ft. from S. Line

_____ Ft. from E. Line

330 Ft. from W. Line

		o	

Location _____

Rig up _____

Drilling and Remarks:

Flow 1488 bbls
in 14 Hours.

Shut in

RECORD

Cased 18 in., 3415 ft.

Sand Hunter 3451-58

Gas _____

Oil _____

Total Depth 3458

PRODUCTION

1st 24 hrs. Nat. _____

1st 24 hrs. after shot _____

Gas _____ Cu. Ft.

Dry Hole _____

Abandoned _____

Date

DEC 28 1932

192

CHAS. L. SHERWOOD

Scout