


McPherson

Form 51-5M-2-29-34703

Map No. KANSAS Sec. 33 Twp. 21 R. 3w

Well No. 2- Klassen Farm
Mabee & Ball Company

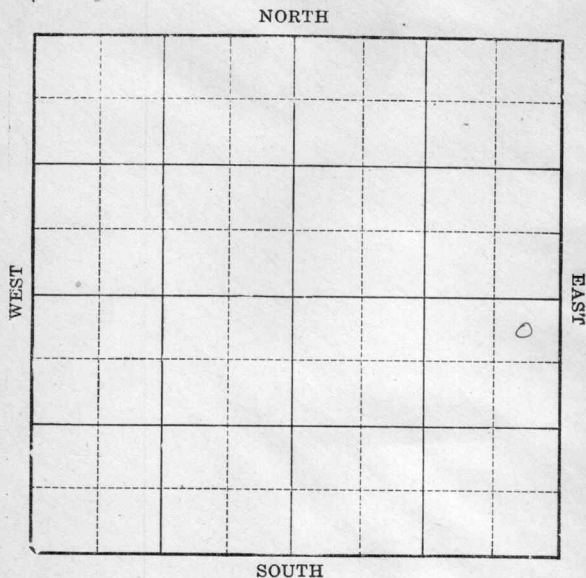

Location _____

Drilling Remarks _____

Rig Up _____

Drilling Remarks _____

RECORD

Cased _____ in. _____ ft.

Sand _____

Gas _____

Oil _____

Total Depth _____

PRODUCTION

1st 24 hrs. Nat. _____

1st 24 hrs. after shot _____

Gas _____ cu. ft.

Dry Hole _____

Abandoned _____

Map No. KANSAS Sec. 33 Twp 21 R. 3^w


Well No. 2-Klassen Farm
Mabee & Shell Company

330 Ft. from N. Line

 Ft. from S. Line

330 Ft. from E. Line

 Ft. from W. Line

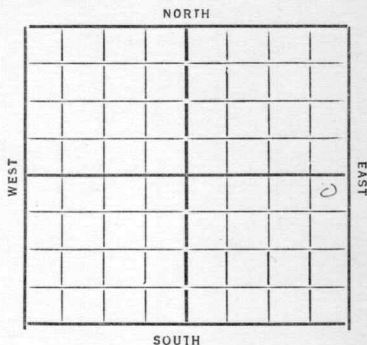

1933

Date

REPORT

1/11

Log

1/18

Core 12"-245'

1/25

15"-245'

dreg 2150'

2/1

Top Chat 3130

dreg 3215

2/8

Core 8"-3452' Rust

2/15

2/22

Meisner sand 3458-62

Huntton 3466-78

T.D. 3478

swab 276 bbl 2 1/4 hr

Still pump

3/1

Sand Huntton 3466-78

Potential prod

pump 2276 bbls

24 hours T.D. 3478

(Comp)

McPherson

W/

43 KANSAS

Map No. Sec. 33 Twp. 21 R. 3

Well No. 2 Klassen

Mayer & Phelps Company

Contractor

FIRST REPORTS

SECTION PLAT

330 Ft. from N. Line

Ft. from S. Line

330 Ft. from E. Line

Ft. from W. Line

Location

Rig up

Drilling and Remarks:

P. O. G.

RECORD

Cased.....in., ...ft.

Sand.....

Gas.....

Oil.....

Total Depth.....

PRODUCTION

1st 24 hrs. Nat.....

1st 24 hrs. after shot.....

Gas.....Cu. Ft.

Dry Hole.....

Abandoned.....

Date

JAN 1 1 1933

192

CHAS. L. SHERWOOD

Scout

McPherson

43 KANSAS

Map No. Sec. 33 Twp. 21 R. 3 W

Well No. 2 Klassen

Mabee & Shell Company

Contractor

COMPLETED

330 Ft. from N. Line

Ft. from S. Line

330 Ft. from E. Line

Ft. from W. Line

SECTION PLAT

			0

Location

Rig up

Drilling and Remarks:

Potential Prod

Pump 2276 Bbl

24 Hrs.

RECORD

Cased 18 in., 3452 ft.

Sand Hunter 3466-78

Gas

Oil

Total Depth 3478

PRODUCTION

1st 24 hrs. Nat.

1st 24 hrs. after shot

Gas Cu. Ft.

Dry Hole

Abandoned

Date

MAR 1 1933

192

CHAS. L. SHERWOOD

Scout