
DX 78-1 McPherson

KANSAS

Section 35 Township 21S Range 3W

Well No. #2 Krebhiel

Company E. K. Carey

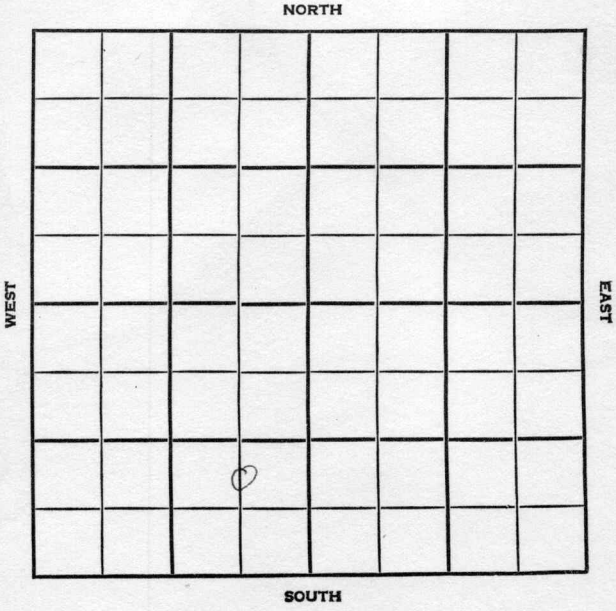

McPherson KANSAS

SEC.	TWP.	R.
35	21	3W

WELL NO.

#2 Krebhiel FARM

COMPANY

E.K. Carey

CONTRACTOR

Co.

Harmac


_____ FT. FROM N. LINE

_____ FT. FROM S. LINE

_____ FT. FROM E. LINE

_____ FT. FROM W. LINE

C N½ SE SW

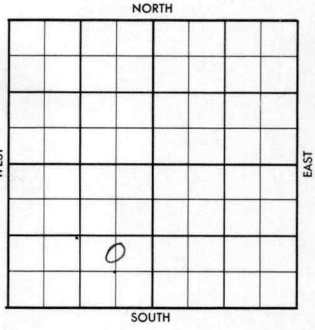

ELEVATION	REPORT
1956	
8-29	Comm. 8-24-56 8" @ 243 w/190 Drlg. 1965'

FORM 504-5 SUNRAY

FORM 513 SUNRAY

County McPherson Elev.

Sec. 35 Twp. 21S Rge. 3W

Company E. N. Carey

Farm Name Krebhiel No. 2

TOPS	DEPTH	LOG	DATUM
Anh.			
Tp.			
H.			
Tr.			
Dg.			
B.L.			
L.			
K.C.			
B.K.C.			
Ce.			
C.			
M.			
M.			
K.			
Mz.			
Mo.			
V.			
S.			
S.			
A			
R.			
P€.			
G.			
T.D.			

Loc. in Sec. C N½ SE SW

Geol.

Contr. Co.

Pool Harmac

AUG 29 '56

FIRST REPORT

Date Comm. 8-24-56

8" 243 w/190; D 1965

Co. Lse. No. Sec. T. R.

SEP 5 1956

R. G.

FORM 513 SUNRAY

County McPherson Elev. 1457

Sec. 35 Twp. 21S Rge. 3W

Company E. K. Carey

Farm Name Krabbiel No. 2

TOPS	DEPTH	LOG	DATUM
Anh.			
Tp.			
H.			
Tr.			
Dg.			
Bl.			
L.			
K.C.			
B.K.C.			
Ce.			
C.			
M.	3137		
M.			
K.	3448		
Mz.	3548		
Mo. Hunt	3552		
V.			
S.			
S.			
A			
R.			
P€.			
G.			
T.D.	3557		

Loc. in Sec. C N½ SE SW

Geol.

Contr. Co.

Pool Harmac

OCT 3 '56

COMPLETE

Date Comm. 8-24-56

8⅝ 243 w/190; D 1965 SEP 5 '56 Ø 3160

SEP 12 '56 5½ 3553/125 SEP 19 '56

co ~~33~~ 3557 FU 240' oil + 300' wtr 40 bo 1/2 SEP 26 '56 ✓

OCT Phl. 33 Bopd + 75 % wtr.

Co. Lse. No. Sec. T. R.