
FORM 51 25M 8-50 WESTERN Barton KANSAS

Section 33 Township 20 Range 14 W

Well No. # 5 McGreevey (B)

Company N C R A

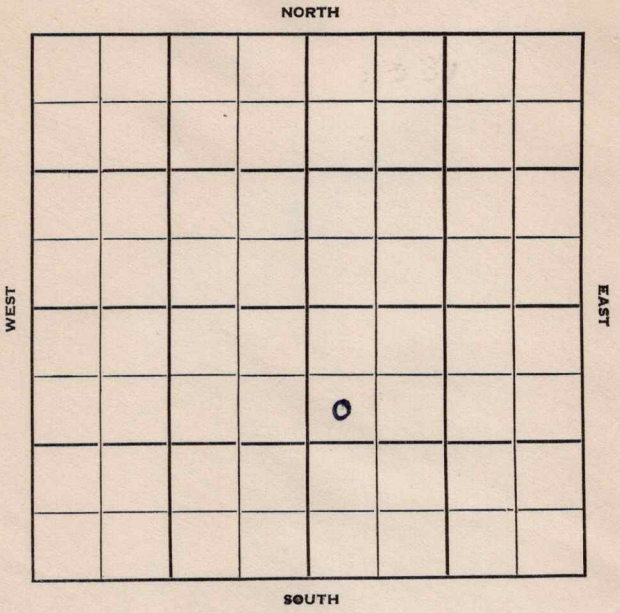

FORM 252-B
10M 8-51 TPCO.

KANSAS

Barton

Sec. 33 Twp. 20 R. 14W

Well No. #5 McGreevey (B) Farm

N C R A Company

Garvie Contractor


990 Ft. from N. Line

Ft. from S. Line

Ft. from E. Line

330 Ft. from W. Line

SW NW SE

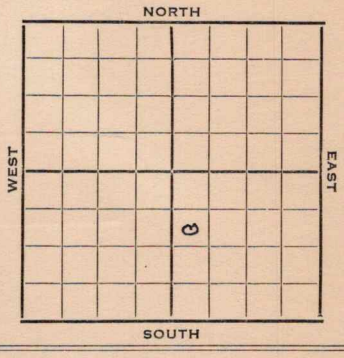

1952	Elev. 1918' REPORT
5/28	Spud 5-21-52 Anhy 830' 8" @ 845'
6/11	Heeb. 3179' Br Li 3280 Lans. 3292' Drlg. 3550'
6/18	Simp Shale 3536 Arb. 3550 DST 3579-88 2 hrs. 2760' oil 10% wtr 70' OCM 170' muddy wtr 1060# DST 3586-98 2 hrs. 2055' SW & Trace oil 1110# RTD 3618 Schl 5" @ 3617
6/25	NR
7/2	NR
7/9	DP
7/16	Spud 5-21-52 Oil Well TD 3618 Anhy 830 8" @ 845 Heeb. 3179 Br Lime 3280 Lans. 3292 Simp 3536 Arb. 3550 DST 3579-88 opn 2 hr. Rec. 2760' oil 10% wtr 70' ocm 170' muddy wtr 1060# DST 3586-98 opn 2 hr. Rec. 2055' sw 1110# TD 3618 5" @ 3617 DP to 3595 20/3586-92 250 A FU 2590' oil 200' w 2 hr S/16 bf Comp. 212 bopd COMPLETED

FORM 275 FOR SALE BY KANSAS BLUE PRINT CO.


County Barton State Kansas

Sec. 33 (Blk. / Twp.) 20 (Sur. / Rge.) 14W Map No.

Operator N. C. R. A.

Well No. 5 Farm McGreevey (B)

Elev. 1918 Location SW NW SE

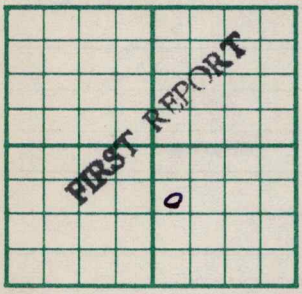

990 Ft. From N Line SE

330 Ft. From W Line Quarter

1st. Report MAY ? 8 1952

Completion

Remarks

Garvie - Contr.

Spudding Date 5-21-52

Drlg. Data

Anhy 830 8" @ 845

J. G. McGEHEE

FORM 275 FOR SALE BY KANSAS BLUE PRINT CO.


County Barton State Kansas

Sec. 33 (Blk. Twp.) 20 (Sur. Rge.) 14W Map No.

Operator N C R A

Well No. 5 Farm McGreevey "B"

Elev. 1918 Location SW NW SE

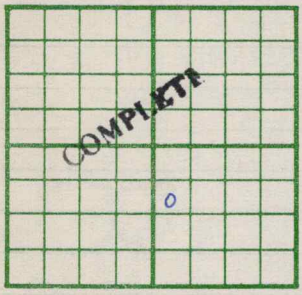

990 Ft. From N Line SE

330 Ft. From W Line Quarter

1st. Report

Completion JUL 1 6 1952

Remarks

Garvey - Contr.

Spudding Date 5-21-52

Drlg. Data Oil well TD 3618

Anhy 830 8" @ 845 Heeb. 3179

Br. lime 3280 Lans. 3292 Simp. 3536

Arb. 3550 DST 3579-88 open 2 hr.

Rec. 2760' oil 10% water 70' ocm

170' muddy water 1060# DST 3586-98

open 2 hr. Rec. 2055' sw 1110#

TD 3618 5" @ 3617 DP to 3595

20/ 3586-92 250 A FU 2590' oil 200' w

2 hr. S/ 16 bf Comp. 212 bopd

J. G. McGEHEE