

M^cPherson


Form 51-5M-2-29-34703

Map No. KANSAS Sec. 33 Twp. 21 R. 3^w

Well No. 2- Koehn (Koehn) Farm

Mabee & Shell Company

NORTH

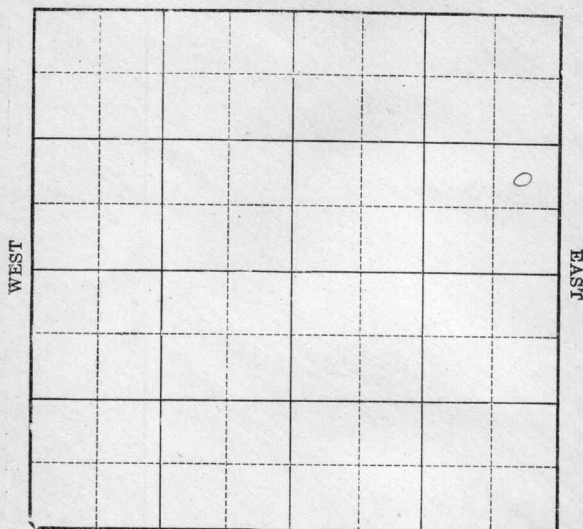

SOUTH

Location _____

Drilling Remarks _____

Rig Up _____

Drilling Remarks _____

RECORD

Cased _____ in. _____ ft.

Sand _____

Gas _____

Oil _____

Total Depth _____

PRODUCTION

1st 24 hrs. Nat. _____

1st 24 hrs. after shot _____

Gas _____ cu. ft.

Dry Hole _____

Abandoned _____


Map No. KANSAS Sec. 33 Twp 21 R. 3^w
Well No. 2 - Keohn Farm
Mabee & O'Neil Company

 Ft. from N. Line

990 Ft. from S. Line

330 Ft. from E. Line

 Ft. from W. Line

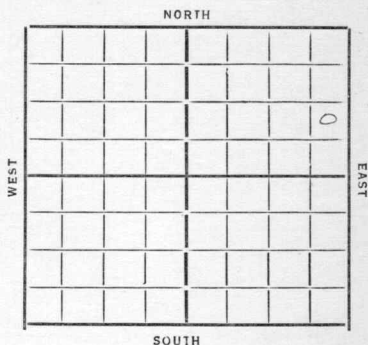

1933

Date

REPORT

1/11	Loc
1/18	Cellar
1/25	Fig
2/11	Ran up
2/8	Set sur pipe 246'
2/15	Dreg 16.75
2/22	" 3045'
3/4	
3/8	~~BT~~ Top Chat 3127 - B.L. 3335' 8" 3460' Meiner sand 3463' - 64' T.D. Rust
3/15	Meiner sand 3462 - 3464' shale 3464 - 74' T.D. swaf 30 bbl powder preparing to pump
3/22	Sand 3462 - 3464 (meiner ^{sand}) pump 732 bbls 24 hours T.D. 3474 (Completed)

McPherson
 43 KANSAS

w

Map No. _____ Sec. *33* Twp. *21* R. *3*

Well No. *2 Keahn*

Make & Shell

Company

Contractor

FIRST REPORTS

_____ Ft. from N. Line

990 Ft. from S. Line

330 Ft. from E. Line

_____ Ft. from W. Line

SECTION PLAT

			o

Location ☒

Rig up _____

Drilling and Remarks:

RECORD

Cased _____ in., _____ ft.

Sand _____

Gas _____

Oil _____

Total Depth _____

PRODUCTION

1st 24 hrs. Nat. _____

1st 24 hrs. after shot _____

Gas _____ Cu. Ft.

Dry Hole _____

Abandoned _____

Date

JAN 11 1933 CHAS. L. SHERWOOD

192

Scout

McPherson
 73 KANSAS
 Map No. _____ Sec. 33 Twp. 21 R. 3

Well No. 2 *Keokuk*
Maher & Sheel Company

Contractor

COMPLETED

SECTION PLAT

			0
		5	

_____ Ft. from N. Line

990 Ft. from S. Line

330 Ft. from E. Line

_____ Ft. from W. Line

Location _____

Rig up *Meisner* _____

Drilling and Remarks:

Pump 732
bes 24 hours

RECORD

Cased 8 in. 3460 ft.

Sand 3462 - 3464

Gas _____

Oil _____

Total Depth 3474

PRODUCTION

1st 24 hrs. Nat. _____

1st 24 hrs. after shot _____

Gas _____ Cu. Ft.

Dry Hole _____

Abandoned _____

Date

MAR 22 1933

192

CHAS. L. SHERWOOD

Scout