

Sec. 15 Twp. 18 R. 1W

Well No. 10 Schultz Farm

Anderson-Prichard Company

McPherson County


330 Ft. from N. Line

Ft. from S. Line

330 Ft. from E. Line

Ft. from W. Line

NE NW

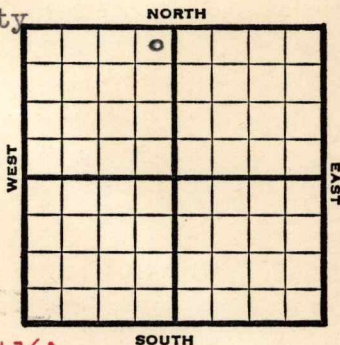

Elev. 1416'

1947

REPORT

3/26 RUR

4/2 8" @ 126'
Drlg. 2622'.

4/9 Miss 2700-03
TD 2703'
5" @ 2702'
RUST

4/15 TD 2729½'
600 Oil 1 Hr.

4/23 " "

4/29 " "

5/7 " "

5/14 Miss 2700'
5" @ 2702'
500 Acid
Pump 297 Pot
3610 Gr.
TD 2729½'

COMPLETED

Kansas

Map No. K42 Sec. 15- Twp. 18 R. 1W

Well No. 10 Schultz

Anderson-Prichard Company

FIRST REPORT

Contractor

NE NW

SECTION PLAT

		o	

330 Ft. from N. Line

_____ Ft. from S. Line

330 Ft. from E. Line

_____ Ft. from W. Line

McPherson County

Location _____

Rig up _____

Drilling and Remarks:

R U R

RECORD

Cased _____ in., _____ ft.

Sand _____

Gas _____

Oil _____

Total Depth _____

PRODUCTION

1st 24 hrs. Nat. _____

1st 24 hrs. after shot _____

Gas _____ Cu. Ft.

Dry Hole _____

Abandoned _____

Date

MAR 26 1947

19

S. J. LEWIS

Scout

Map No. K42 Sec. 15 Twp. 18 R. 1W

Well No. 10 Schultz

Anderson-Prichard Company

COMPLETE

Contractor

NE NW

E. 1/4/6
SECTION PLAT

330 Ft. from N. Line

_____ Ft. from S. Line

330 Ft. from E. Line

_____ Ft. from W. Line

	0		

McPherson County

Location _____

Rig up _____

Drilling and Remarks:

Miss 2700
5' @ 2702
5-80 acid
Pump 227 BX

36° SW

RECORD

Cased _____ in., _____ ft.

Sand _____

Gas _____

Oil _____

Total Depth 2728 1/2

PRODUCTION

1st 24 hrs. Nat. _____

1st 24 hrs. after shot _____

Gas _____ Cu. Ft.

Dry Hole _____

Abandoned _____

Date

MAY 14 1947

S. J. LEWIS

Scout