


McPherson

Form 51-5M-11-31-Palace

Map No. *KANSAS* Sec. *33* Twp. *21* R. *3^W*

Well No. *1-Boehn* Farm

W.C. McBride, Inc Company

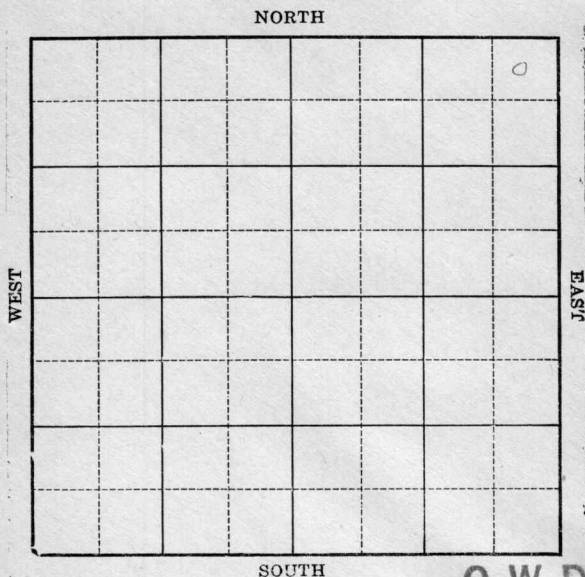

Location _____

Drilling Remarks _____

RECORD

Cased _____ in. _____ ft.

Sand _____

Gas _____

Oil _____

Total Depth _____

Rig Up _____

Drilling Remarks _____

PRODUCTION

1st 24 hrs. Nat. _____

1st 24 hrs. after shot _____

Gas _____ cu. ft.

Dry Hole _____

Abandoned _____

Map No. KANSAS Sec. 33 Twp 21 R. 3^W

Well No. 1-Koehn Farm


W.C. Mc Bride, Inc. Company

330 Ft. from N. Line

_____ Ft. from S. Line

330 Ft. from E. Line

_____ Ft. from W. Line

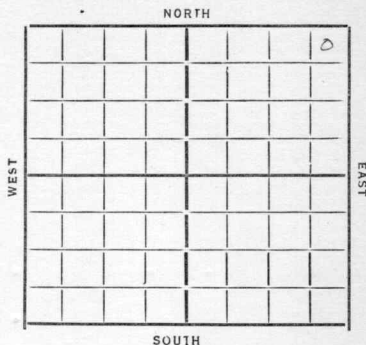

1933

Date	REPORT	O. W. D. D
<u>2/8</u>	<u>Rotary rig</u>	
<u>2/15</u>	<u>6128</u>	
<u>2/22</u>	<u>7/5</u>	
<u>3/14</u>	<u>7/12</u>	
<u>3/18</u>	<u>7/19</u>	
<u>3/15</u>	<u>7/26</u>	
<u>3/22</u>	<u>8/2</u>	
<u>3/29</u>	<u>8/9</u>	
<u>4/4</u>	<u>8/17</u>	
<u>4/12</u>	<u>8/23</u>	
<u>4/19</u>	<u>8/30</u>	
<u>4/26</u>	<u>9/6 2op chat 3105. 10rlg 3125</u>	
<u>5/4</u>	<u>9/13 - T D 3405 A.M. ST.</u>	
<u>5/10</u>	<u>9/20</u>	
<u>5/17</u>	<u>(Over)</u>	
<u>5/24</u>		
<u>6/1</u>		
<u>6/8</u>		
<u>6/15</u>	<u>10" 2412 dily 2538</u>	
<u>6/15</u>		
<u>6/21</u>	<u>10" 2452 8" 2789 dily 2810</u>	
<u>6/21</u>	<u>Rotary Rig (Over)</u>	

1933

9/20 Top Hunton 3431 T.D. 3443 shot 15 gts
Swab 2 bbls per hr.

9/29 well acidize

10/5 pump 107 bbls 5 hrs

10/11- Hunton 3431

T. D. 3443

350 bbls

COMPLETED

O. W. D. D

1936

12/29 T. D. 3455'.

Pump 25 oil. 6 water.

FIRST REPORTS

and

COMPLETED

McPherson

43 KANSAS

Map No. Sec. 33 Twp. 21 R. 3^W

Well No. 1 Koehn

N.C. Mc Bride, Inc. Company

Contractor

FIRST REPORTS

SECTION PLAT

330 Ft. from N. Line

Ft. from S. Line

330 Ft. from E. Line

Ft. from W. Line

			0

Location

Rig up

Drilling and Remarks:

Rotary Rig

RECORD

Cased in., ft.

Sand

Gas

Oil

Total Depth

PRODUCTION

1st 24 hrs. Nat.

1st 24 hrs. after shot

Gas Cu. Ft.

Dry Hole

Abandoned

Date

FEB 8 1933

192

CHAS. L. SHERWOOD

Scout

Map No. 43 Sec. 33 Twp. 21 R. 3W

Well No. 1- Koe hn

W. C. McBride, Inc. Company

Contractor

SECTION PLAT

			0

330 Ft. from N. Line

..... Ft. from S. Line

330 Ft. from E. Line

..... Ft. from W. Line

COMPLETED

Location.....

Rig up.....

Drilling and Remarks:

RECORD

Cased.....in.,.....ft.

Sand Hutton 34 31

Gas.....

Oil.....

Total Depth 344 3

PRODUCTION

1st 24 hrs. Nat.....

1st 24 hrs. after shot.....

Gas.....Cu. Ft.

Dry Hole.....

Abandoned.....

350 lbs

Date

10-11-33 192 O. Marsh Scout

KANSAS

Map No. _____ Sec. 33 Twp. 21 R. 3WWell No. 1 Toe lineH. C. Mc Bride Inc Company

Contractor

SECTION PLAT

330 Ft. from N. Line

_____ Ft. from S. Line

330 Ft. from E. Line

_____ Ft. from W. Line

FIRST REPORT
COMPLETED
ON 11/1

			0

Location _____

Rig up _____

Drilling and Remarks:

Old TD 3443 1/2Pump 25 oil
6 water

RECORD

Cased _____ in., _____ ft.

Sand _____

Gas _____

Oil _____

Total Depth 3455

PRODUCTION

1st 24 hrs. Nat. _____

1st 24 hrs. after shot _____

Gas _____ Cu. Ft.

Dry Hole _____

Abandoned _____

Date

DEC 29 1936

19

S. J. LEWIS

Scout