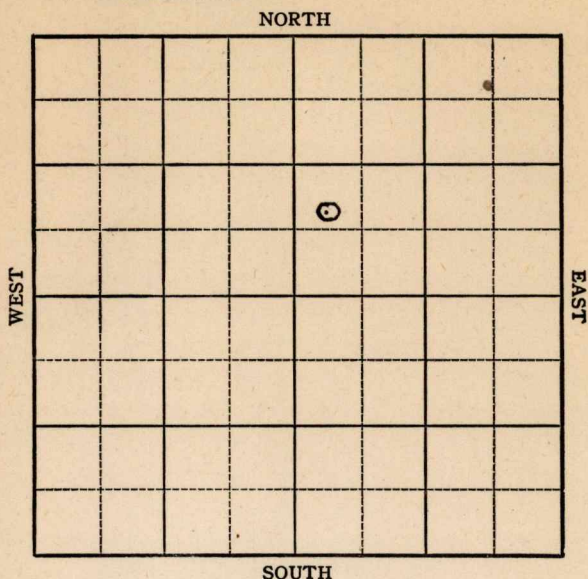


KANSAS

McPherson

Section 30 Township 18 Range 2-WWell No. #1 JohnsonCompany C R A
McPherson

KANSAS

McPherson

Sec. 30 Twp. 18 R. 2W

Well No. 1 Johnson Farm

C R A

Mc Pherson Pool

Contr. NORTH C R A

Ft. from N. Line


880

Ft. from S. Line

Ft. from E. Line

330

Ft. from W. Line

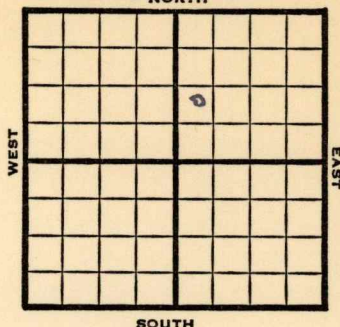

NW SW NE

1949

Elev 1554'

REPORT

8/24

Twin well

8" @ 260

8/31

Drlg. 2760'

9/7

Miss 2863'

Viola 3214'

Arbuckle 3319'

TD 3329'

5" @ 3319'

9/14

16 @ one shots 3214-18

Swb 30 bbls oil 12 hrs.

2% W

9/21

"

9/28

TD 3329'

Arb. 3319'

5" @ 3319'

Pump 35 Oil Pot

37° Gr.

Comp

COMPLETED

Kansas

Map No. _____ Sec. 30 Twp. 18 R. 2WWell No. 1 Johnson


C R A

Company

C R A

Contractor

NW SW NE

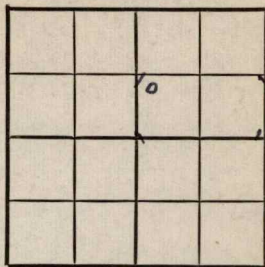FIRST REPORT
SECTION PLAT

_____ Ft. from N. Line

880 Ft. from S. Line

_____ Ft. from E. Line

330 Ft. from W. Line

McPherson County

Location _____

Rig up _____

Drilling and Remarks:

twin well

8" @ 260

RECORD

Cased _____ in., _____ ft.

Sand _____

Gas _____

Oil _____

Total Depth _____

PRODUCTION

1st 24 hrs. Nat. _____

1st 24 hrs. after shot _____

Gas _____ Cu. Ft.

Dry Hole _____

Abandoned _____

Date

AUG 24 1949

19

S. J. LEWIS

Scout

Kansas

Map No. _____ Sec. 30 Twp. 18 R. 2WWell No. 1 Johnson


C R A

Company

COMPLETE

Contractor

NW SW NE

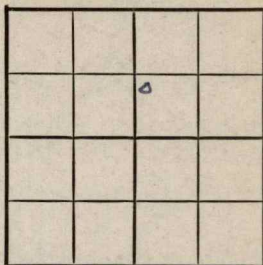E 11554
SECTION PLAT

_____ Ft. from N. Line

880

_____ Ft. from S. Line

_____ Ft. from E. Line

330

_____ Ft. from W. Line

McPherson County

Location _____

Rig up _____

Drilling and Remarks:

Per X33185" C3318Pump 35 oil 1st87 1/2

RECORD

Cased _____ in., _____ ft.

Sand _____

Gas _____

Oil _____

Total Depth 3325

PRODUCTION

1st 24 hrs. Nat. _____

1st 24 hrs. after shot _____

Gas _____ Cu. Ft.

Dry Hole _____

Abandoned _____

Date

SEP 28 1949

19

S. J. LEWIS Scout