


KANSAS *M^cPherson*

Map No. _____ Sec. *33* Twp. *21* R. *3^W*
Well No. *2 Koehn* (*Koehn*) Farm
D.C. M^cBride Company

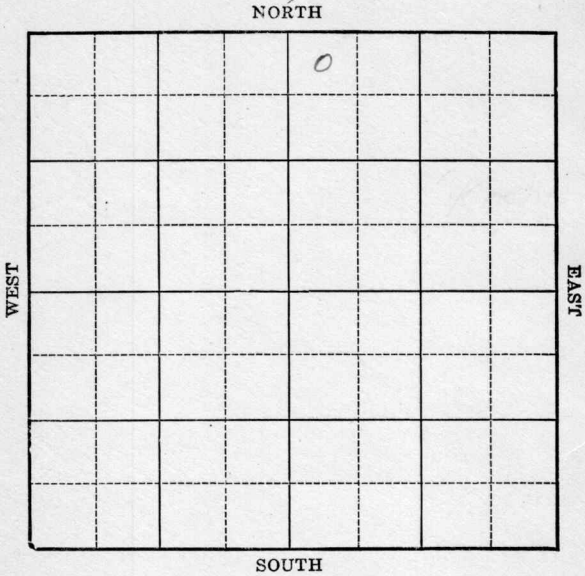

Location _____
Drilling Remarks _____

Rig Up _____
Drilling Remarks _____

RECORD

Cased _____ in. _____ ft.
Sand _____
Gas _____
Oil _____
Total Depth _____

PRODUCTION

1st 24 hrs. Nat. _____
1st 24 hrs. after shot _____
Gas _____ cu. ft.
Dry Hole _____
Abandoned _____

McPherson

Form 252-A
5M 4-32 MPC

KANSAS

Map No. _____ Sec. 33 Twp. 21 R. 3W

Well No. 2 Keohu Farm _____


W.C. Mc Bride Inc. Company

330 Ft. from N. Line

_____ Ft. from S. Line

_____ Ft. from E. Line

330' Ft. from W. Line

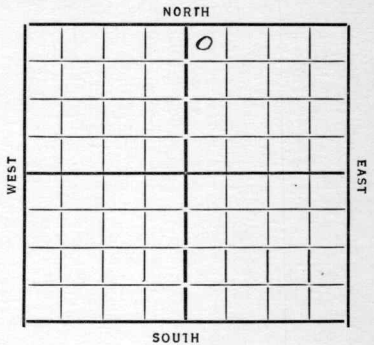

Date 1933

REPORT

5/3 Location

5/10 Bldg Rig

5/17 sped

5/24 20" 163 - 15" 423 dely 625'

6/1 bly 1400

6/8 13" 1828 H.F.W. 2200' dely 2280'

6/15 10" 2412 dely 2538'

6/21 10" 2452 - 8" 2789 dely 2810

6/28 Chat 3101' T.D. 3103 - show gas M.P. 8"

7/5 -

7/12 Chat 3113 Corrected 8" 3115 T.D. 3160

7/19 B.L. 3205 Top Henton 3443 M.P. 6"

3436' - 1500' at 3. minutes

swab 30 bbls per hr T.D. 3446 1/2

7/26 Top henton 3443

T.D. 3450

548 bbls

43 KANSAS

McPherson

Map No. _____ Sec. 33 Twp. 21 R. 3

Well No. 2 Keokuk

N. C. McBridge, Inc. Company

Contractor

FIRST REPORTS

SECTION PLAT

330 Ft. from N. Line

_____ Ft. from S. Line

_____ Ft. from E. Line

330 Ft. from W. Line

		0	

Location _____ ✓

Rig up _____

Drilling and Remarks:

RECORD

Cased _____ in., _____ ft.

Sand _____

Gas _____

Oil _____

Total Depth _____

PRODUCTION

1st 24 hrs. Nat. _____

1st 24 hrs. after shot _____

Gas _____ Cu. Ft.

Dry Hole _____

Abandoned _____

Date

MAY 3 1933

CHAS. L. SHERWOOD

192

Scout

Map No. 43 Sec. 33 Twp. 21 R. 3WWell No. 2-KeohnW. C. McBride Company

Contractor

SECTION PLAT


330 Ft. from N. Line

Ft. from S. Line

Ft. from E. Line

330 Ft. from W. Line

COMPLETED

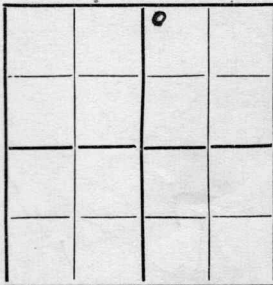

Location

Rig up

Drilling and Remarks:

Huntton 3443548 fbls

RECORD

Cased.....in.,ft.

Sand.....

Gas.....

Oil.....

Total Depth 3450

PRODUCTION

1st 24 hrs. Nat.....

1st 24 hrs. after shot.....

Gas.....Cu. Ft.

Dry Hole.....

Abandoned.....

Date

7/26/33 192 W. C. McBride Scout