


McPherson

KANSAS

Form 51-5M-11-31-Palace

Map No. _____ Sec. 33 Twp. 21 R. 3W

Well No. 2- Mabel Farm
Mabee + Shell Company

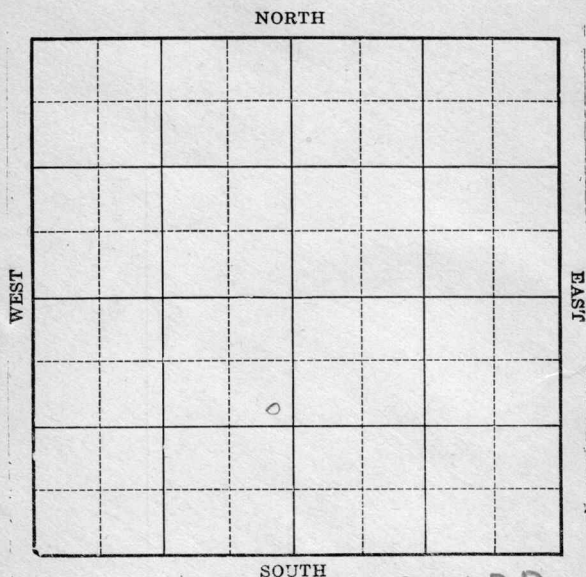

Location _____

Drilling Remarks _____

Rig Up _____

Drilling Remarks _____

RECORD

Cased _____ in. _____ ft.

Sand _____

Gas _____

Oil _____

Total Depth _____

PRODUCTION

1st 24 hrs. Nat. _____

1st 24 hrs. after shot _____

Gas _____ cu. ft.

Dry Hole _____

Abandoned _____

McPherson

Form 252-A
5M 4-32 MPC

KANSAS

Map No. _____ Sec. 33 Twp. 21 R. 3W

Well No. 2-nikkel Farm _____


Mabee + Shell Company

990 Ft. from N. Line

_____ Ft. from S. Line

330 Ft. from E. Line

_____ Ft. from W. Line

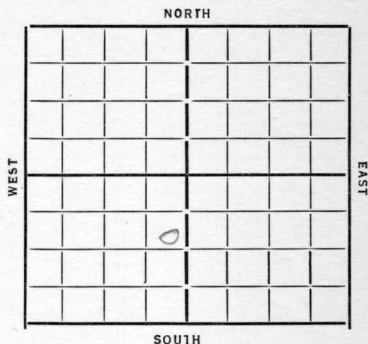

Date 1933

REPORT

7/19 Location

7/26 _____

8/2 Rig

8/4 _____

8/17 15" 267 W.O.C.

8/23 _____

8/30 K.O. line 2390 Top Chat 3164
Wdly 3242

9/6 Rig Line 3333 - 8" 3463 - Top
Huntan 3468 T D 3473 RUST.

9/13 T D 3474 - pump 35 bbls per hr
12 hrs - putting on pump.

9/20 Huntan 3468
T. D. 3474

potential 724 bbls

COMPLETED

1933

OWDD

10/18 Dr/G. 3478 1000 gallon acid

10/25 T.D. 3478 1000 gal acid
pump 47 bbls per hour

COMPLETED

Map No. 43 Sec. 33 Twp. 21 R. 3WWell No. #2 - NickelMabee & Shell Company

Contractor


SECTION PLAT

990 Ft. from N. Line

Ft. from S. Line

330 Ft. from E. Line

Ft. from W. Line

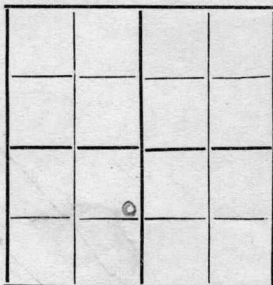

FIRST REPORTS

Location ✓

Rig up

Drilling and Remarks:

RECORD

Cased in., ft.Sand Gas Oil Total Depth

PRODUCTION

1st 24 hrs. Nat. 1st 24 hrs. after shot Gas Cu. Ft.Dry Hole Abandoned

Date

7/19/33 192 Coal Mammoch Secut

Map No. 43 Sec. 33 Twp. 21 R. 3 W

Well No. 2- Nippel

Mabeu + Shell Company

Contractor

SECTION PLAT

990 Ft. from N. Line

Ft. from S. Line

330 Ft. from E. Line

Ft. from W. Line

COMPLETED

Location

Rig up

Drilling and Remarks:

potential
724 bbls

RECORD

Cased in., ft.

Sand gunton 3468

Gas

Oil

Total Depth 3474

PRODUCTION

1st 24 hrs. Nat.

1st 24 hrs. after shot

Gas Cu. Ft.

Dry Hole

Abandoned

Date

9/29/33 O. Mammuch Scout


Map No. 43 Sec. 33 Twp. 21 R. 3W

Well No. 2- N. H. K. L.

Wabbe & Shell Company

Contractor

SECTION PLAT

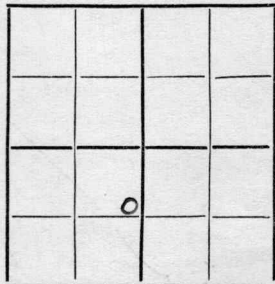

990 **FIRST REPORTS**

Ft. from N. Line

Ft. from S. Line

330 Ft. from E. Line

Ft. from W. Line

O. W. S.

Location

Rig up

Drilling and Remarks:

OT 3474

Blg 3478
1000 gal acid

RECORD

Cased _____ in., _____ ft.

Sand _____

Gas _____

Oil _____

Total Depth _____

PRODUCTION

1st 24 hrs. Nat. _____

1st 24 hrs. after shot _____

Gas _____ Cu. Ft.

Dry Hole _____

Abandoned _____

Date

10-18-33 192 O. Mammuch Scout

Map No. 43 Sec. 33 Twp. 21 R. 3W

Well No. 2-Mikkel

Mabe & Shell Company

Contractor

SECTION PLAT

990 Ft. from N. Line

..... Ft. from S. Line

330 Ft. from E. Line

..... Ft. from W. Line

COMPLETED

Location.....

Rig up.....

Drilling and Remarks:

1000 gal and

pumps 47 bbls per hr

RECORD

Cased.....in., ...ft.

Sand.....

Gas.....

Oil.....

Total Depth 3478

PRODUCTION

1st 24 hrs. Nat.....

1st 24 hrs. after shot.....

Gas.....Cu. Ft.

Dry Hole.....

Abandoned.....

Date

10-25-33 192 A. Mammuch Scout