


McC Pherson

Map No. _____ Sec. *33* Twp. *21* R. *34*
 Well No. *4 McKel* Farm _____
Maber & Shell Company _____

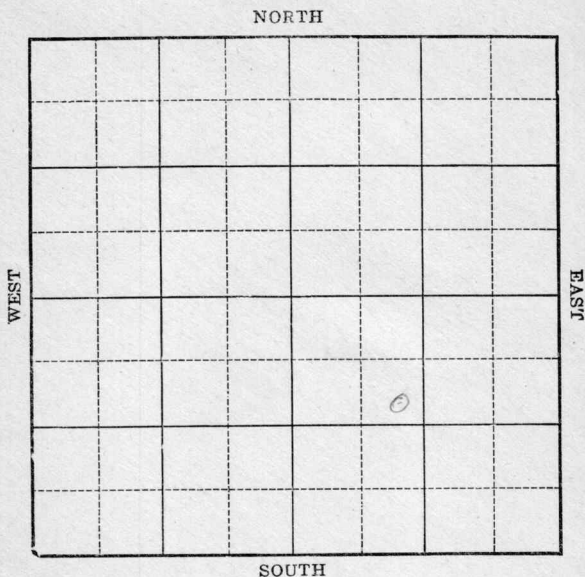

Location _____
 Drilling Remarks _____

Rig Up _____
 Drilling Remarks _____

RECORD

Cased _____ in. _____ ft.
 Sand _____
 Gas _____
 Oil _____
 Total Depth _____

PRODUCTION

1st 24 hrs. Nat. _____
 1st 24 hrs. after shot _____
 Gas _____ cu. ft.
 Dry Hole _____
 Abandoned _____

M. E. Larson
 Map No. 43 Sec. 33 Twp. 21 R. 3W

Well No. 4-Nikkel

Mabe & Shell Company

Contractor

FIRST REPORTS


990 Ft. from N. Line

..... Ft. from S. Line

..... Ft. from E. Line

990 Ft. from W. Line

SECTION PLAT

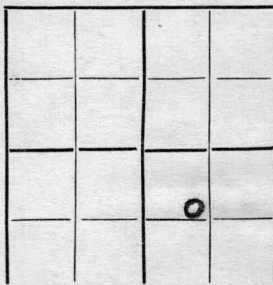

Location.....

Rig up.....

Drilling and Remarks:

cellar

RECORD

Cased.....in.,ft.

Sand.....

Gas.....

Oil.....

Total Depth.....

PRODUCTION

1st 24 hrs. Nat.....

1st 24 hrs. after shot.....

Gas.....Cu. Ft.

Dry Hole.....

Abandoned.....

Date

11-8-33 192. O. Manschick Scout

Map No. 43 Sec. 33 Twp. 21 R. 3W

Well No. 4- Nippel

Mabee & Shell Company

Contractor

COMPLETED

SECTION PLAT

990 Ft. from N. Line

..... Ft. from S. Line

..... Ft. from E. Line

990 Ft. from W. Line

		0	

Location.....

Rig up.....

Drilling and Remarks:

1000 gal acid

Swab 1780
bbls

RECORD

Cased.....in.,ft.

Sand Buntan 3468

Gas.....

Oil.....

Total Depth 3488

PRODUCTION

1st 24 hrs. Nat.....

1st 24 hrs. after shot.....

Gas.....Cu. Ft.

Dry Hole.....

Abandoned.....

Date

1-17-34 192 C. Mannick Scout