


Section 16 Township 18 Range 1W

Well No. #1 Holdeman

Company Don Allen, etal

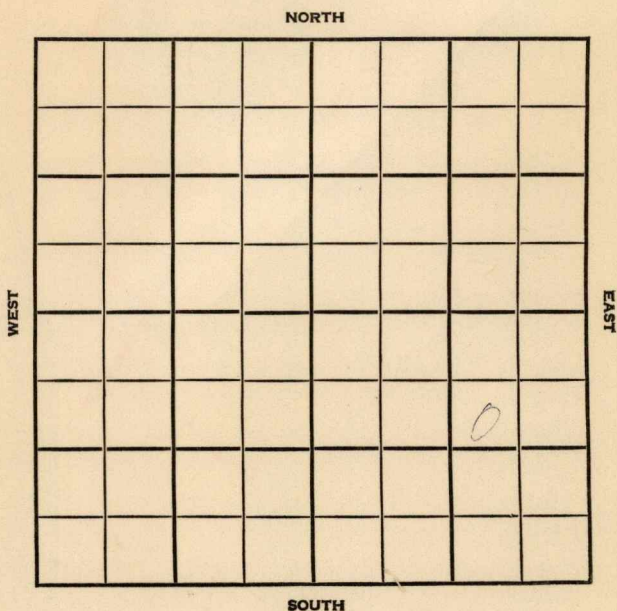

County McPherson Elev. 1431  
 Sec. 16 Twp. 18 Rge. 1W  
 Company Don Allen, etal  
 Farm Name Holdeman No. 1

TOPS	DEPTH	LOG	DATUM	Loc. in Sec.
Anh.				SW NE SE
Tp.				
H.				
Tr.				
Dg.				
Bl.	2112			
L.	2165			Geol.
K.C.				Contr.
B.K.C.				Greenland Top
Ce.				
C.				
M. <u>chat</u>	2731			Pool
M.				Paden
K.				
Mz.				
Mq.				
V.				
S.				
S.				
A.				
R.				
PE.				
G.				
TD	2760			DEC 13 '56

Date Comm. MIRT NOV 13 '56 11-7-56 8518  
151/100 5 1/2 2750/150 NOV 21 '56 wact  
NOV 28 '56 ca 2760 TD in BOP.  
P. 1 BFpk 50% wtr to  
re Acid DEC 5 '56 ✓ DEC 12 '56 P. 25  
Bopd + 2 Bw pd.

