


McPherson

Form 51—5M—11-31—Palace

Map No. **KANSAS** Sec. **33** Twp. **21** R. **3W**

Well No. **8 Nickel "B"** Farm
Mabe & Shell Company

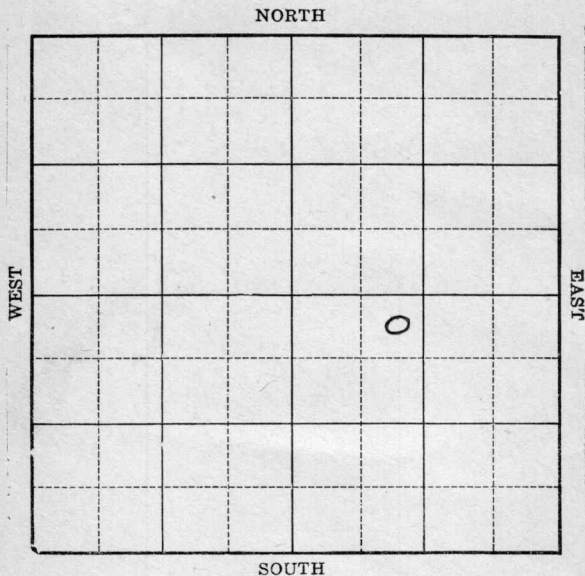

Location

Drilling Remarks

Rig Up

Drilling Remarks

RECORD

Cased in. ft.

Sand

Gas

Oil

Total Depth

PRODUCTION

1st 24 hrs. Nat.

1st 24 hrs. after shot

Gas cu. ft.

Dry Hole

Abandoned

McPherson


Map No. KANSAS Sec. 33 Twp. 21 R. 3W
Well No. 8 Nikkel "B" Farm
Mabu & Shell Company

330 Ft. from N. Line

_____ Ft. from S. Line

_____ Ft. from E. Line

990 Ft. from W. Line

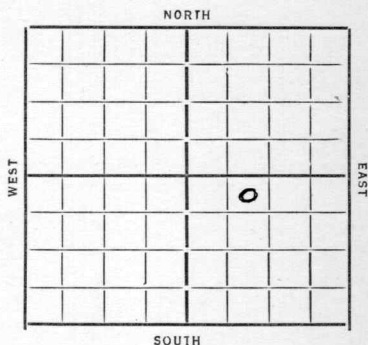

Date 1934

REPORT

5/2 Location
5/10 _____
5/18 B. R.
5/25 dog 342 15" 314
5/31 " 3107
6/7 " 3296 Chit 3150
6/14 B. Miss 3329 T.H. 3455-64
7" 3454 Rust
6/27 Hunter 3455 TD 3475
1000 acid 1609 Blk.

COMPLETED

KANSAS

Map No. 43 Sec. 33 Twp. 21 R. 3WWell No. 8- Nickel (B)Mayer + Shell Company

Contractor

FIRST REPORTS

330 Ft. from N. Line

_____ Ft. from S. Line

_____ Ft. from E. Line

990 Ft. from W. Line

SECTION PLAT

		0	

Location _____

Rig up _____

Drilling and Remarks: _____

RECORD

Cased _____ in., _____ ft.

Sand _____

Gas _____

Oil _____

Total Depth _____

PRODUCTION

1st 24 hrs. Nat. _____

1st 24 hrs. after shot _____

Gas _____ Cu. Ft.

Dry Hole _____

Abandoned _____

Date

5-2-34

19

ORVAL MANNSCHRECK

Scout

KANSAS

Form 26—1M Bks.—2-29

Map No. 43 Sec. 33 Twp. 21 R. 3W

Well No. 8-Mikkel 'B'

Mabe + Shell Company

Contractor

COMPLETED

SECTION PLAT

		0	

330 Ft. from N. Line

_____ Ft. from S. Line

_____ Ft. from E. Line

990 Ft. from W. Line

Location _____

Rig up _____

Drilling and Remarks:

1000 acid

1609 bbls

RECORD

Cased _____ in., _____ ft.

Sand Hutton 3455

Gas _____

Oil _____

Total Depth 3475

PRODUCTION

1st 24 hrs. Nat. _____

1st 24 hrs. after shot _____

Gas _____ Cu. Ft.

Dry Hole _____

Abandoned _____

Date

6-21-37 19

ORVAL MANNSCHRECK

Scout