


McPherson

Form 51-5M-11-31-Palace

Map No. KANSAS Sec. 34 Twp. 21 R. 3w

Well No. 1 - Greb Hill Farm

Carrio & Shell Company

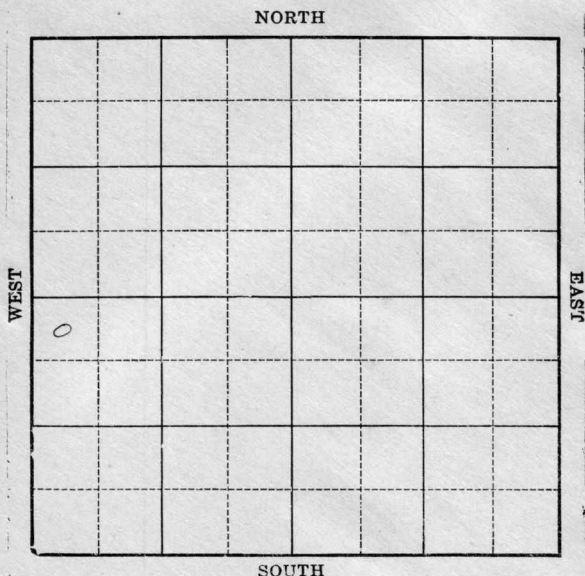

Location

Drilling Remarks

Rig Up

Drilling Remarks

RECORD

Cased in. ft.

Sand

Gas

Oil

Total Depth

PRODUCTION

1st 24 hrs. Nat.

1st 24 hrs. after shot

Gas cu. ft.

Dry Hole

Abandoned

Map No. KANSAS Sec. 34 Twp 21 R. 3^W

Well No. 1-Krehvil Farm
Lario & Shell Company


330 Ft. from N. Line

_____ Ft. from S. Line

_____ Ft. from E. Line

330 Ft. from W. Line

1933

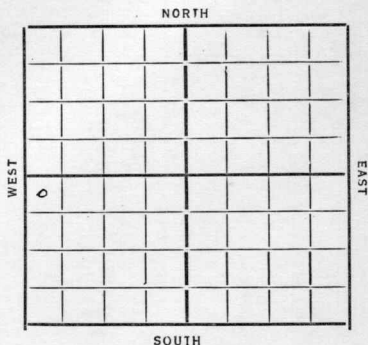

Date

REPORT

1/4	Cellar
1/11	Rig
1/18	Cem 12"-234
1/25	Drlg 2595'
2/1	Top Chat 3136
	drlg 3217
2/8	Base line 3363
	Top Huntori 3474
	Cem 8"-3474 Rust
2/15	—
2/22	TD 3478
	sump 185 bbl 8 hrs
3/4	No potential test
3/8	—
3/10	—
3/22	—
3/29	—
4/4	Sump 135 bbls 3 hrs
4/12	No test
4/19	8"-3474' Sand 3474-78' T.L. Potential
	Prod Recump 1196 bbls 24 hrs
	Completed

43 KANSAS Map No. Sec. 34 Twp. 21 R. 3

Well No. 1 Krehlin

Lario & Shoop Company

Contractor

FIRST REPORTS

330 Ft. from N. Line

Ft. from S. Line

Ft. from E. Line

330 Ft. from W. Line

SECTION PLAT

0			

Location

Rig up Cellar

Drilling and Remarks:

RECORD

Cased in., ft.

Sand

Gas

Oil

Total Depth

PRODUCTION

1st 24 hrs. Nat.

1st 24 hrs. after shot

Gas Cu. Ft.

Dry Hole

Abandoned

Date

JAN 4 1933

192

CHAS. L. SHERWOOD

Scout

43 KANSAS Map No. _____ Sec. 34 Twp. 21 R. 3

Well No. 1 Krehbier
Lario & Sheer Company

Contractor

COMPLETED

SECTION PLAT

330 Ft. from N. Line

_____ Ft. from S. Line

_____ Ft. from E. Line

330 Ft. from W. Line

Location _____

Rig up _____

Drilling and Remarks:

Potential Prod

Pump 1196

Bls 24 hours

RECORD

Cased 8 in., 3424 ft.

Sand 3474-3478

Gas _____

Oil _____

Total Depth 3478

PRODUCTION

1st 24 hrs. Nat. _____

1st 24 hrs. after shot _____

Gas _____ Cu. Ft.

Dry Hole _____

Abandoned _____

Date

APR 19 1933

192

CHAS. L. SHERWOOD

Scout