


Map No. _____ Sec. 8 Twp. 21 R. 4W
Well No. 1- Aschmayer Farm _____
Hollow itel Company _____

NORTH

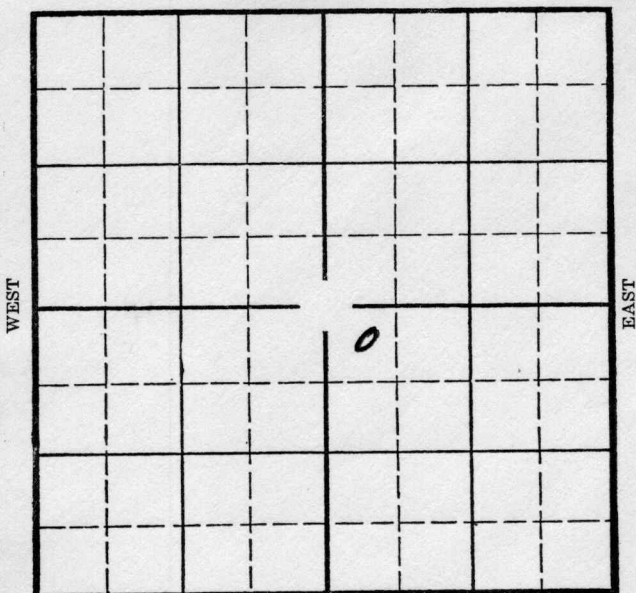

SOUTH

Location _____
Drilling Remarks _____

Rig Up _____
Drilling Remarks _____

RECORD

Cased _____ in. _____ ft.
Sand _____
Gas _____
Oil _____
Total Depth _____

PRODUCTION

1st 24 hrs. Nat. _____
1st 24 hrs. after shot _____
Gas _____ cu. ft. _____
Dry Hole _____
Abandoned _____

McPherson

Map No. KANSAS Sec. 8 Twp. 21 R. 4W


Well No. 1- Aschman Farm
Hollow itel Company

330 Ft. from N. Line

_____ Ft. from S. Line

_____ Ft. from E. Line

330 Ft. from W. Line

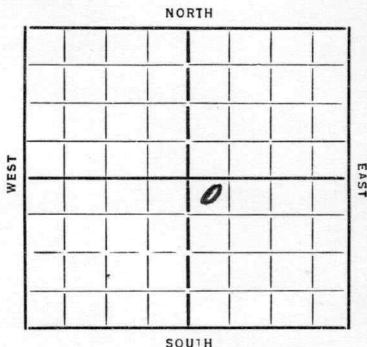

Elev. 1516

Date 1935 REPORT

6/5 yno H.
6/18 Moving
6/20 Rig
6/28 R 2
7/3 Alg 480 15" 245
7/14 " 1330
7/18 12" 2 1730
8/8 10" 2648 KC 2700
8/15 HF W 2790-95
8/22 Alg 3020 8" 2880
8/22 " 3152
8/29 3335 Lower 8"
9/6 TC 3365 HF W 3465-75
9/20 8" 3357 Alg 3508
9/20 Sil 3982
9/20 T 3995

7.0 A.

ABANDONED

Map No. 48 Sec. 8 Twp. 21 R. 4WWell No. 1- AschmanHallow et al Company

Contractor

FIRST REPORTS

SECTION PLAT

		0	

330 Ft. from N. Line

Ft. from S. Line

Ft. from E. Line

330 Ft. from W. Line

Location

Rig up

Drilling and Remarks:

RECORD

Cased in., ft.

Sand

Gas

Oil

Total Depth

PRODUCTION

1st 24 hrs. Nat.

1st 24 hrs. after shot

Gas Cu. Ft.

Dry Hole

Abandoned

Date

6-5-35

192

ORVAL MANNSCHRECK

Scout

Map No. 48 Sec. 8 Twp. 21 R. 4W

Well No. 1-Aschman

Hollow et al Company

Contractor

ABANDONED

KANSAS

SECTION PLAT

330 Ft. from N. Line

Ft. from S. Line

Ft. from E. Line

330 Ft. from W. Line

		0	

Location

Rig up

Drilling and Remarks:

N # N

RECORD

Cased 21 in. 3982 ft.

Sand 21

Gas

Oil

Total Depth 3995

PRODUCTION

1st 24 hrs. Nat.

1st 24 hrs. after shot

Gas Cu. Ft.

Dry Hole

Abandoned

Date

9-20-35

192

ORVAL MANNSCHECK

Scout