


Barton **KANSAS**

Section 34 Township 20 Range 14 W

Well No. # 1 Pritchard

Company Rocket Drlg.

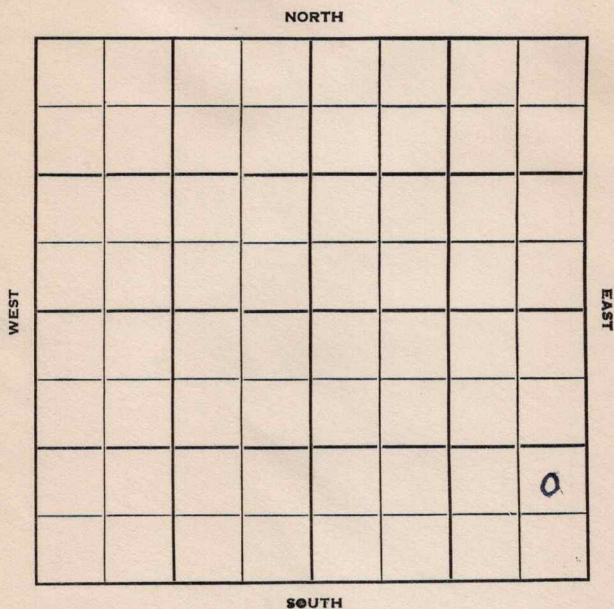

Sec. 34 Twp. 20 R. 14W

Well No. #1 Pritchard Farm

Rocket Drlg. Company

Rocket Pritchard Contractor


Ft. from N. Line

990 Ft. from S. Line

330 Ft. from E. Line

Ft. from W. Line

NE SE SE

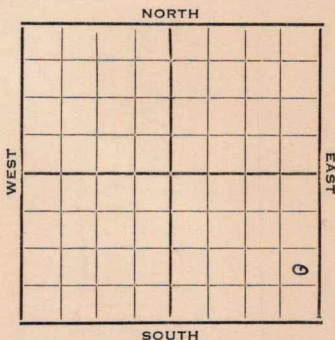

1952

Elev. 1908

REPORT

5/28

Spud 5-22-52

8" @ 814'

Anhy 802'

Drlg. 2422'

6/11

RTD 3565' 5" @ 3564 CO 3565

1/2 Boph 250 A S/ 4 Boph & some wtr.

6/18

POP

6/25

NR

7/2

NR

7/9

NR

7/17

NR

7/23

Spud 5-22-52

Oil Well TD 3565

8" @ 814 Anhy 802

Heeb. 3162 Br lime 3279

Lans. 3291

DST 3285-3324 opn 1 hr.

Rec. 10' ocm Off

DST 3407-70 opn 1 hr. gas in 55 min.

Rec. 60' o & gcm 600' muddy oil

& hocm 990# Cong. 3506

DST 3503-27 opn 1 hr. Rec. 10' mud

Simp 3525 Arb. 3564 TD 3565

5" @ 3564 CO to 3565 1/2 boph 250A


S/4 boph Comp. 34 bopd 50% wtr

County **Barton** State **Kansas**
 Sec. **34** (Blk.) **20** (Sur.) **14W** Map No.

Operator **Rocket Drlg.**

Well No. **1** Farm **Pritchard**

Elev. Location **NE SE SE**

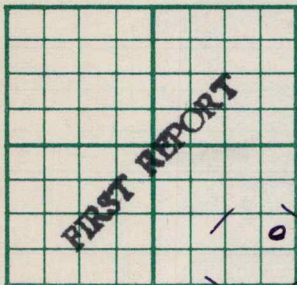

990 Ft. From **S** Line **SE**

330 Ft. From **E** Line Quarter

1st. Report **MAY 28 1952**

Completion

Remarks

Rocket - Contr.

Spudding Date **5-22-52**

Drlg. Data **Pritchard**

8" @ 814 Anhy 802 Drlg. 2422


J. G. McGEHEE

County Barton State Kansas
 Sec. 34 (Blk.) 20 (Sur.) 14 Map No.

Operator Rocket Drlg.

Well No. 1 Farm Pritchard

Elev. 1908 Location NE SE SE

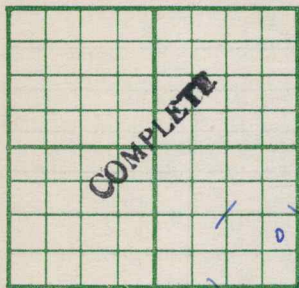

990 Ft. From S Line SE

330 Ft. From E Line Quarter

1st. Report

Completion JUL 23 1952

Remarks Pritchard Pool
Rockett Drlg. - Contr.

Spudding Date 5-22-52

Drlg. Data Oil well TD 3565

8" @ 814 Anhy 802 Heeb. 3162

Br. lime 3279 Lans. 3291 DST 3285-

3324 open 1 hr. Rec. 10' ocm 0#

DST 3407-70 open 1 hr. gas in 55 min.

Rec. 60' o & gcm 600' muddy oil & hocm

990# Cong. 3506 DST 3503-27

open 1 hr. Rec. 10' mud Simp. 3525

Arb. 3564 TD 3565 5" @ 3564

CO to 3565 $\frac{1}{2}$ boph 250 A S/ 4 boph

Comp. 34 bopd 58% water

J. G. McGEHEE